

Work Order ID 142409

March 08, 2016 3:10:49 PM

142409

Page 1

Item ID: D4273-042 Accept ***N900040100*** Setup Start ***NS1***
 Revision ID: Stop ***NS2***
 Item Name: Basket Base Assembly, RH
 Start Date: 3/14/2016 Start Qty: 1.00 ***1*** Cust Item ID:
 Required Date: 3/29/2016 Req'd Qty: 1.00 ***1*** Customer:
 Reference:

Approvals: Process Plan: SM Date: 20160308 Tooling: _____ Date: _____ Run Start ***NR1***
 QC: _____ Date: _____ SPC (Y/N): _____ Date: _____ Stop ***NR2***

Sequence ID/ Work Center ID	Operation Description	Set Up/ Run Hours	Tool ID	Tool #	Plan Code	Accept Qty	Reject Qty	Reject Number	Insp. Stamp
Draw Nbr	Revision Nbr								
D4273	E								
D4279	B								

100 Weld per dwg A/R S.S. rod Batch 4134102 0.00

100

Large Fab

Large Fab

Large Fab

Memo

0.05

1- assemble ribs and handle plates (DO NOT WELD HANDLE IN SECTION N-N ON PAGE 7 DWG D4273, NEED TO WELDED AFTHET MESH IS INSTALL) weld as per dwg D4273 using DT9610A

visual inspect before welding mesh

2- Cut D4279-1 (MADE ON THIS W/O) base mesh and tack weld all mesh on basket as per dwg D4273 and trim mesh to fit if necessary and trim to clear fasteners holes on the ends (D4279-5/-9)

3- weld hinge (3) and Mounting brackets as per dwg D3913
 take lid to locate hinge and bracket

4- Weld D4672-1 blanking plates as per dwg

1x CC 16-3-16

DAS
43
9-89

MAR 16 2016

DQA: _____ Date: _____



WORK ORDER NON-CONFORMANCE / UPDATE

QA Closed: _____ Date: _____

Work Order update only ☐

Work Order: _____ Part No. _____ NCR No. _____		DISPOSITION Rework ☐ Scrap ☐ Use-as-is ☐ Suspected Unapproved ☐		AGAINST DEPARTMENT/PROCESS Skid-tube ☐ Machining ☐ Thermoforming ☐ Large Fab ☐ Cross tube ☐ Small Fab ☐ Finishing ☐ Composite ☐ Water Jet ☐ Prod. Eng. Coord. ☐ Rec/Store/Packaging ☐ Supplier ☐ Engineering ☐ Quality ☐ Other ☐	
Date :		Step #:		QTY Effective :				MRB (QSI042) Approval	
Description Work Order Deviation				Disposition				Completed By Lead hand / Supervisor Approval Verification QC / QA Coordinator Approval	
Root Cause		FAULT CATEGORY	
Environment ☐	No Re-verification ☐	Pressure/Forced ☐	Temperature/Cure ☐	Power Loss/Surge ☐	Positioned Wrong ☐	Design ☐	Operator ☐	Bending ☐	Set-up ☐	Folio/Program ☐	Outside Dimensions ☐	Doc/Data ☐	Offset/Setup ☐	Centre Not Concentric ☐	BOM/Route ☐	Grain ☐	Over/Under tolerance ☐	Equip/Tooling ☐	Supplier ☐	Cracks ☐	Broken/Damage/Defect ☐	Weld ☐	Part Incorrect ☐	Handling/Pre ☐	Training ☐	Crimp/Kink/Ripple/Wave ☐	Inspection Incomplete/Unqualified ☐	Wrong Stock Pulled ☐	Part Lost/Missing ☐	Material ☐	Use for Testing ☐	Cuffs ☐	Contamination ☐	Out of Sequence ☐	Part Moved ☐	Internal Transport ☐	Poor Information ☐	Crushing ☐	Countersink ☐	Off-set ☐	Drawing ☐	Tribal Knowledge ☐	Rushing ☐	Heat Treat ☐	Cut Too Short ☐	Mislabeled ☐	Finish ☐	LOA ☐	Product Improvement ☐	Wave/Twist in Tube ☐	Instructions Incomplete/Unclear ☐	Fit/Function ☐	Misread ☐	Substation ☐	Process Improvement ☐	Marks/Chatter ☐	Drill Holes ☐	Misaligned/off center ☐	Turning Sequence ☐	Past Expiry Date ☐	Manufacturing Process ☐	OTHER : _____			
Misidentified ☐	Past Due ☐	

Work Order ID 142409

March 08, 2016 3:10:49 PM

142409

Page 2

Item ID: D4273-042

Accept

N900040100Setup Start ***NS1***

Revision ID:

Stop ***NS2***

Item Name: Basket Base Assembly, RH

Start Date: 3/14/2016 Start Qty: 1.00

1

Cust Item ID:

Required Date: 3/29/2016 Req'd Qty: 1.00

1

Customer:

Reference:

Approvals: Process Plan: _____ Date: _____ Tooling: _____ Date: _____
QC: _____ Date: _____ SPC (Y/N): _____ Date: _____

Run Start ***NR1***Stop ***NR2***

Sequence ID/ Work Center ID	Operation Description	Set Up/ Run Hours	Tool ID	Tool #	Plan Code	Accept Qty	Reject Qty	Reject Number	Insp. Stamp
110	QC9- Inspect visual per QSI004- Fusion Welds	0.00				1		MAR 17 2016	DAS 24 9-00
110									
QC	Memo	0.00							
Quality Control									
120	QC6- Inspect dimensions to drawing	0.00						MAR 17 2016	DAS 24 9-00
120									
QC	Memo	0.00							
Quality Control									
125	Pressure Wash per QSI005 4.3	0.00							
125									
HandFinish	Memo	0.01							
Hand Finishing									

1 ϕ 16-03-17. 24 9-00

DQA: _____ Date: _____



WORK ORDER NON-CONFORMANCE / UPDATE

QA Closed: _____ Date: _____

Work Order update only ☐

Work Order: _____ Part No. _____ NCR No. _____		DISPOSITION Rework ☐ Scrap ☐ Use-as-is ☐ Suspected Unapproved ☐		AGAINST DEPARTMENT/PROCESS Skid-tube ☐ Machining ☐ Thermoforming ☐ Large Fab ☐ Cross tube ☐ Small Fab ☐ Finishing ☐ Composite ☐ Water Jet ☐ Prod. Eng. Coord. ☐ Rec/Store/Packaging ☐ Supplier ☐ Engineering ☐ Quality ☐ Other ☐					
Date :		Step #:		QTY Effective :				MRB (QS1042) Approval	
Description Work Order Deviation				Disposition				Completed By Lead hand / Supervisor Approval Verification QC / QA Coordinator Approval	
Root Cause		FAULT CATEGORY							
Environment ☐	☐ No Re-verification	☐ Pressure/Forced	☐ Temperature/Cure	☐ Power Loss/Surge	☐ Positioned Wrong				
Design ☐	☐ Operator	☐ Bending	☐ Set-up	☐ Folio/Program	☐ Outside Dimensions				
Doc/Data ☐	☐ Offset/Setup	☐ Centre Not Concentric	☐ BOM/Route	☐ Grain	☐ Over/Under tolerance				
Equip/Tooling ☐	☐ Supplier	☐ Cracks	☐ Broken/Damage/Defect	☐ Weld	☐ Part Incorrect				
Handling/Pre ☐	☐ Training	☐ Crimp/Kink/Ripple/Wave	☐ Inspection Incomplete/Unqualified	☐ Wrong Stock Pulled	☐ Part Lost/Missing				
Material ☐	☐ Use for Testing	☐ Cuffs	☐ Contamination	☐ Out of Sequence	☐ Part Moved				
Internal Transport ☐	☐ Poor Information	☐ Crushing	☐ Countersink	☐ Off-set	☐ Drawing				
Tribal Knowledge ☐	☐ Rushing	☐ Heat Treat	☐ Cut Too Short	☐ Mislabeled	☐ Finish				
LOA ☐	☐ Product Improvement	☐ Wave/Twist in Tube	☐ Instructions Incomplete/Unclear	☐ Fit/Function	☐ Misread				
Substation ☐	☐ Process Improvement	☐ Marks/Chatter	☐ Drill Holes	☐ Misaligned/off center	☐ Turning Sequence				
Past Expiry Date ☐	☐ Manufacturing Process	OTHER :							
Misidentified ☐	☐ Past Due								

Work Order ID 142409

March 08, 2016 3:10:49 PM

142409

Page 3

Item ID: D4273-042 Accept ***N900040100*** Setup Start ***NS1***
 Revision ID: Stop ***NS2***
 Item Name: Basket Base Assembly, RH
 Start Date: 3/14/2016 Start Qty: 1.00 ***1*** Cust Item ID:
 Required Date: 3/29/2016 Req'd Qty: 1.00 ***1*** Customer:
 Reference:

Approvals: Process Plan: _____ Date: _____ Tooling: _____ Date: _____ Run Start ***NR1***
 QC: _____ Date: _____ SPC (Y/N): _____ Date: _____ Stop ***NR2***

Sequence ID/ Work Center ID	Operation Description	Set Up/ Run Hours	Tool ID	Tool #	Plan Code	Accept Qty	Reject Qty	Reject Number	Insp. Stamp
130	White Gloss(Ref:4.3.5.2) per OSI005 4.3-Steel	0.00							
130	<i>M 133462</i>								
Powdercoat	Memo	0.01							
Powder Coating	1- Plug holes and mask only interior of hinge (3) prior to powder coat								
	1ST COAT: <i>1:20</i>								
	START TIME: <i>1:20</i>								
	OVEN TEMPERATURE: <i>400°</i>								
	FINISH TIME: <i>1:50</i>								
	***** 2nd coat if necessary *****								
	2ND COAT:								
	START TIME: _____								
	OVEN TEMPERATURE: _____								
	FINISH TIME: _____								
140	QC3- Inspect Part Finish	0.00							
140									
QC	Memo	0.00							
Quality Control									

1 16-03-17. 238

12 p 16/03/17

DAS
15
9-89

DQA: _____ Date: _____



WORK ORDER NON-CONFORMANCE / UPDATE

QA Closed: _____ Date: _____

Work Order update only ☐

Work Order: _____ Part No. _____ NCR No. _____	DISPOSITION Rework ☐ Scrap ☐ Use-as-is ☐ Suspected Unapproved ☐	AGAINST DEPARTMENT/PROCESS Skid-tube ☐ Machining ☐ Thermoforming ☐ Large Fab ☐ Cross tube ☐ Small Fab ☐ Finishing ☐ Composite ☐ Water Jet ☐ Prod. Eng. Coord. ☐ Rec/Store/Packaging ☐ Supplier ☐ Engineering ☐ Quality ☐ Other ☐			
Date :	Step #:	QTY Effective :		MRB (QS1042) Approval	
Description Work Order Deviation		Disposition			
				Completed By	
				Lead hand / Supervisor Approval Verification	
				QC / QA Coordinator Approval	
Root Cause Environment ☐ Design ☐ Doc/Data ☐ Equip/Tooling ☐ Handling/Pre ☐ Material ☐ Internal Transport ☐ Tribal Knowledge ☐ LOA ☐ Substation ☐ Past Expiry Date ☐ Misidentified ☐ No Re-verification ☐ Operator ☐ Offset/Setup ☐ Supplier ☐ Training ☐ Use for Testing ☐ Poor Information ☐ Rushing ☐ Product Improvement ☐ Process Improvement ☐ Manufacturing Process ☐ Past Due ☐		FAULT CATEGORY Pressure/Forced ☐ Bending ☐ Centre Not Concentric ☐ Cracks ☐ Crimp/Kink/Ripple/Wave ☐ Cuffs ☐ Crushing ☐ Heat Treat ☐ Wave/Twist in Tube ☐ Marks/Chatter ☐ Temperature/Cure ☐ Set-up ☐ BOM/Route ☐ Broken/Damage/Defect ☐ Inspection Incomplete/Unqualified ☐ Contamination ☐ Countersink ☐ Cut Too Short ☐ Instructions Incomplete/Unclear ☐ Drill Holes ☐ Power Loss/Surge ☐ Folio/Program ☐ Grain ☐ Weld ☐ Wrong Stock Pulled ☐ Out of Sequence ☐ Off-set ☐ Misabeled ☐ Fit/Function ☐ Misaligned/off center ☐ Positioned Wrong ☐ Outside Dimensions ☐ Over/Under tolerance ☐ Part Incorrect ☐ Part Lost/Missing ☐ Part Moved ☐ Drawing ☐ Finish ☐ Misread ☐ Turning Sequence ☐			
☐ OTHER : _____					

Work Order ID 142409

March 08, 2016 3:10:49 PM

142409

Page 4

Item ID: D4273-042

Accept

N900040100

Setup Start

NS1

Revision ID:

Stop

NS2

Item Name: Basket Base Assembly, RH

Start Date: 3/14/2016 Start Qty: 1.00

1

Cust Item ID:

Required Date: 3/29/2016 Req'd Qty: 1.00

1

Customer:

Reference:

Approvals:

Process Plan: _____

Date: _____

Tooling: _____

Date: _____

Run Start

NR1

QC: _____

Date: _____

SPC (Y/N): _____

Date: _____

Stop

NR2Sequence ID/
Work Center IDOperation
DescriptionSet Up/
Run Hours

Tool ID

Tool #

Plan
CodeAccept
QtyReject
QtyReject
NumberInsp.
Stamp

150

Identify as per dwg & Stock Location: w/c

0.00

150

Packaging

Memo

0.00

D4273-042/B142393

1 0 0 1 6 3 1

Packaging

160

QC21- Final Inspection - Work Order Release

0.00

160

QC

Memo

0.00

MCS MAR 21 2016

Quality Control

MAR 21 2016

MCS

DQA: _____ Date: _____



WORK ORDER NON-CONFORMANCE / UPDATE

QA Closed: _____ Date: _____

Work Order update only ☐

Work Order: _____ Part No. _____ NCR No. _____	DISPOSITION Rework ☐ Scrap ☐ Use-as-is ☐ Suspected Unapproved ☐	AGAINST DEPARTMENT/PROCESS Skid-tube ☐ Machining ☐ Thermoforming ☐ Large Fab ☐ Cross tube ☐ Small Fab ☐ Finishing ☐ Composite ☐ Water Jet ☐ Prod. Eng. Coord. ☐ Rec/Store/Packaging ☐ Supplier ☐ Engineering ☐ Quality ☐ Other ☐			
Date : _____	Step #: _____	QTY Effective : _____		MRB (QSI042) Approval	
Description Work Order Deviation		Disposition			
				Completed By	
				Lead hand / Supervisor Approval Verification	
				QC / QA Coordinator Approval	
Root Cause Environment ☐ Design ☐ Doc/Data ☐ Equip/Tooling ☐ Handling/Pre ☐ Material ☐ Internal Transport ☐ Tribal Knowledge ☐ LOA ☐ Substation ☐ Past Expiry Date ☐ Misidentified ☐ No Re-verification ☐ Operator ☐ Offset/Setup ☐ Supplier ☐ Training ☐ Use for Testing ☐ Poor Information ☐ Rushing ☐ Product Improvement ☐ Process Improvement ☐ Manufacturing Process ☐ Past Due ☐		FAULT CATEGORY Pressure/Forced ☐ Bending ☐ Centre Not Concentric ☐ Cracks ☐ Crimp/Kink/Ripple/Wave ☐ Cuffs ☐ Crushing ☐ Heat Treat ☐ Wave/Twist in Tube ☐ Marks/Chatter ☐ Temperature/Cure ☐ Set-up ☐ BOM/Route ☐ Broken/Damage/Defect ☐ Inspection Incomplete/Unqualified ☐ Contamination ☐ Countersink ☐ Cut Too Short ☐ Instructions Incomplete/Unclear ☐ Drill Holes ☐ Power Loss/Surge ☐ Folio/Program ☐ Grain ☐ Weld ☐ Wrong Stock Pulled ☐ Out of Sequence ☐ Off-set ☐ Misabeled ☐ Fit/Function ☐ Misaligned/off center ☐ Positioned Wrong ☐ Outside Dimensions ☐ Over/Under tolerance ☐ Part Incorrect ☐ Part Lost/Missing ☐ Part Moved ☐ Drawing ☐ Finish ☐ Misread ☐ Turning Sequence ☐			
OTHER : ☐					

Picklist Print

March 08, 2016 3:10:54 PM

Page 1

Work Order ID: 142409

142409

Parent Item: D4273-042

D4273-042

Parent Item Name: Basket Base Assembly, RH

Start Date: 3/14/2016

Required Date: 3/29/2016

Start Qty: 1.00

Required Qty: 1.00

Comments: IPP Rev:A 10.11.16 new issue DD verf:EC IPP Rev:B
11.01.20 AS PER DWG REV.C DD verf:EC IPP Rev:C 11.03.03
AS PER DWG REV.D DD verf:EC IPP REV:D 12.07.24 AS PER
DWG REV.E DD VERF:EC

Component Item ID/ Item Name	Replacement Item ID	Mfg/ Purch	Bin Item	Primary Location	Last Location	Route Seq ID	Unit of Measure	Qty on Hand	Qty per Kit	Total Qty	Qty Issued	Date Issued	Status
---------------------------------	------------------------	---------------	-------------	---------------------	------------------	-----------------	--------------------	----------------	-------------	--------------	---------------	----------------	--------

D4672-1		Manufactured	No			100	Each	33.0000	2	2		DAS 43 9-89	MAR 14 2016
---------	--	--------------	----	--	--	-----	------	---------	---	---	--	-------------------	-------------

✓ *D4672-1*
Blanking Plate

Location	Loc Qty	Loc Code
WA004	33	
128829	2	
137124	2	
141229	29	

M304EX0.75-16F		Purchased	No			100	sf	792.0000	32	32		DAS 43 9-89	MAR 14 2016
----------------	--	-----------	----	--	--	-----	----	----------	----	----	--	-------------------	-------------

✓ *M304EX0 75-16F*
Expanded Metal Flat SS

Location	Loc Qty	Loc Code
WA004	792	
M133868	25	
M134184	320	
M134331	447	

D3913-1		Manufactured	No			100	Each	5.0000	1	1		DAS 43 9-89	MAR 14 2016
---------	--	--------------	----	--	--	-----	------	--------	---	---	--	-------------------	-------------

✓ *D3913-1*
Rib

Location	Loc Qty	Loc Code
WA004	5	
141916	5	

Picklist Print

March 08, 2016 3:10:54 PM

Page 2

Work Order ID: 142409

142409

Parent Item: D4273-042

D4273-042

Parent Item Name: Basket Base Assembly, RH

Start Date: 3/14/2016

Required Date: 3/29/2016

Start Qty: 1.00

Required Qty: 1.00

D3913-3 Manufactured No

100 Each

5.0000

1 1

DAS

✓ *D3913-3*

Rib

**B141917 → 1

43

MAR 14 2016

Location

Loc Qty

Loc Code

WA004

5

141917

5

D3913-9 Manufactured No

100 Each

5.0000

1 1

DAS

✓ *D3913-9*

Hinge Rib

**B141425 → 1

43

MAR 14 2016

Location

Loc Qty

Loc Code

WA004

5

141425

5

D3916-5 Manufactured No

100 Each

3.0000

3 3

DAS

✓ *D3916-5*

Light Rib

**B141979 → 3

43

MAR 14 2016

Location

Loc Qty

Loc Code

WA004

3

141979

3

D4017-7 Manufactured No

100 Each

0.0000

3 1

DAS

✓ *D4017-7*

Rib

DAS 22

**B142415 → 3

43

MAR 14 2016

D4277-3 Manufactured No

100 Each

2.0000

1 1

DAS

✓ *D4277-3*

Rib

**B137135 → 1

43

MAR 14 2016

Location

Loc Qty

Loc Code

WA004

2

137135

2

D4277-5 Manufactured No

100 Each

0.0000

2 2

DAS

✓ *D4277-5*

Rib

**B142416 → 2

43

MAR 14 2016

9-89

March 08, 2016 3:10:54 PM

Shop Packet Print

Page 2

Picklist Print

March 08, 2016 3:10:54 PM

Page 3

Work Order ID: 142409

142409

Parent Item: D4273-042

D4273-042

Parent Item Name: Basket Base Assembly, RH

Start Date: 3/14/2016

Required Date: 3/29/2016

Start Qty: 1.00

Required Qty: 1.00

✓ *D4277-9*	D4277-9	Manufactured	No	100	Each	0.0000	1	1	DAS 43 9-89	MAR 14 2016																																	
	Rib	
✓ *D4277-19*	D4277-19	Manufactured	No	100	Each	0.0000	1	1	DAS 43 9-89	MAR 14 2016																																	
	Rib	
✓ *D4278-041*	D4278-041	Manufactured	No	100	Each	0.0000	1	1	DAS 43 9-89	MAR 14 2016																																	
	Upper Rib Assembly-Hoop	
✓ *D4278-045*	D4278-045	Manufactured	No	100	Each	0.0000	2	2	DAS 43 9-89	MAR 14 2016																																	
	Rib Assembly, Fwd Cham	
✓ *D4278-047*	D4278-047	Manufactured	No	100	Each	0.0000	1	1	DAS 43 9-89	MAR 14 2016																																	
	Upper Rib Assembly-Straight	
✓ *D4306-1*	D4306-1	Manufactured	No	100	Each	0.0000	1	1	DAS 43 9-89	MAR 14 2016																																	
	Rib	
✓ *D4306-044*	D4306-044	Manufactured	No	100	Each	2.0000	1	1	DAS 43 9-89	MAR 14 2016																																	
	Rib Assembly, RH	
<table> <tr> <th></th><th><u>Location</u></th><th><u>Loc Qty</u></th><th><u>Loc Code</u></th><th colspan="7"></th></tr> <tr> <td></td><td>WA004</td><td>2</td><td></td><td colspan="7"></td></tr> <tr> <td></td><td>133751</td><td>2</td><td></td><td colspan="7"></td></tr> </table>												<u>Location</u>	<u>Loc Qty</u>	<u>Loc Code</u>									WA004	2										133751	2								
	<u>Location</u>	<u>Loc Qty</u>	<u>Loc Code</u>	
	WA004	2	
	133751	2	
✓ *D4306-045*	D4306-045	Manufactured	No	100	Each	0.0000	1	1	DAS 43 9-89	MAR 14 2016																																	
	Rib Assembly	

March 08, 2016 3:10:54 PM

Shop Packet Print

Page 3

Picklist Print

March 08, 2016 3:10:54 PM

Page 4

Work Order ID: 142409

142409

Parent Item: D4273-042

D4273-042

Parent Item Name: Basket Base Assembly, RH

Start Date: 3/14/2016

Required Date: 3/29/2016

Start Qty: 1.00

Required Qty: 1.00

D2581

Manufactured No

100 Each

34.0000

2 2

DAS

43

9-89

MAR 14 2016

✓ ***D2581***

Mounting Bracket

****B 139082 → 2x**LocationLoc QtyLoc Code

WA004

34

132771

1

136270

2

139082

31

D3913-15

Manufactured No

100 Each

16.0000

1 1

DAS

43

9-89

MAR 14 2016

✓ ***D3913-15***

Wide Handle Plate

****B 141118 → 1x**LocationLoc QtyLoc Code

WA004

16

141118

16

D4016-1

Manufactured No

100 Each

45.0000

3 3

DAS

43

9-89

MAR 14 2016

✓ ***D4016-1***

Hinge Half, Base

****B 137077 → 3**LocationLoc QtyLoc Code

WA004

45

137077

5

140745

40

D4021-1

Manufactured No

100 Each

27.0000

3 3

DAS

43

9-89

MAR 14 2016

✓ ***D4021-1***

Handle Plate

****B 139529 → 3**LocationLoc QtyLoc Code

WA004

27

139529

11

141494

16

Picklist Print

March 08, 2016 3:10:54 PM

Page 5

Work Order ID: 142409

142409

Parent Item: D4273-042

D4273-042

Parent Item Name: Basket Base Assembly, RH

Start Date: 3/14/2016

Required Date: 3/29/2016

Start Qty: 1.00

Required Qty: 1.00

D4279-5

Manufactured No

100

Each

3.0000

1

1

DAS

✓ *D4279-5*

End Mesh, Basket

~~**B103775 → 1~~
B127368 → 1

43
9-89

MAR 14 2016

Location

Loc Qty

Loc Code

WA006

3

127368

3

D4279-7

Manufactured No

100

Each

6.0000

2

2

DAS

✓ *D4279-7*

End Mesh, Basket

~~**B103734 → 2~~

43
9-89

MAR 14 2016

Location

Loc Qty

Loc Code

WA006

6

103480

4

103734

2

D4279-9

Manufactured No

100

Each

3.0000

1

1

DAS

✓ *D4279-9*

End Mesh, Basket

~~**B127741 → 1~~

43
9-89

MAR 14 2016

Location

Loc Qty

Loc Code

WA004

2

131154

2


WA006

1

127741

1

ITEM	QTY -041	PART NUMBER	DESCRIPTION
	X	D4273-041	BASKET BASE ASSY, LH
1	2	D2581	MOUNTING BRACKET
2	1	D3913-15	WIDE HANDLE PLATE
3	3	D4016-1	HINGE HALF, BASE
4	3	D4021-1	HANDLE PLATE
5	1	D4273-141	BASKET FRAME ASSY, LH
6	1	D4279-1	MESH - BASE
7	1	D4279-3	MESH - CHAMFER
8	1	D4279-5	END MESH, BASKET
9	2	D4279-7	END MESH, BASKET
10	1	D4279-9	END MESH, BASKET
11	1	D4279-11	MESH - BASE
12	2	D4672-1	BLANKING PLATE

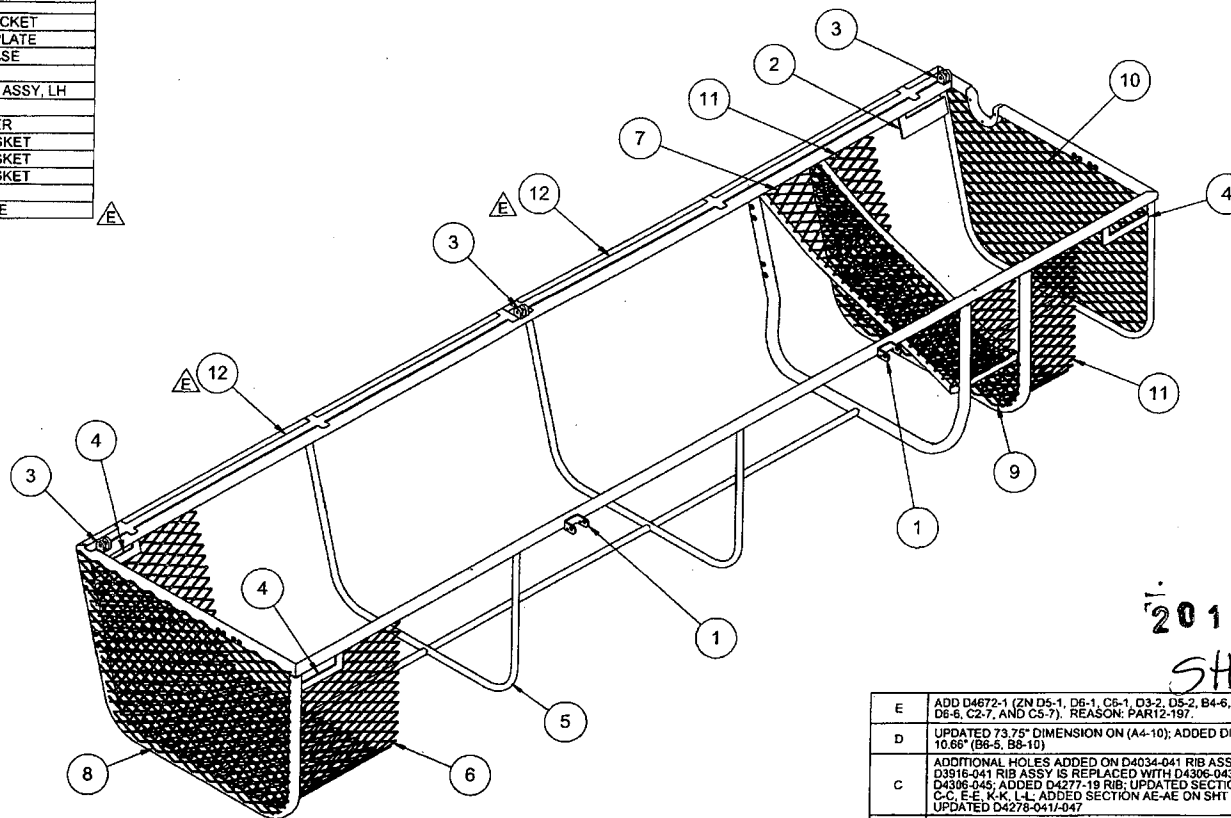


D4273-041 BASKET BASE ASSY, LH
(MESH SHOWN LOCALLY FOR CLARITY)

NOTES:


- 1) MATERIAL: N/A
- 2) FINISH: POWDER COAT WHITE (4.3.5.2) PER DART QSI 005 4.3
- 3) TOLERANCES: PER DART QSI 018 UNLESS OTHERWISE NOTED
- 4) UNITS: INCHES UNLESS OTHERWISE NOTED
- 5) BREAK SHARP EDGES: N/A
- 6) IDENTIFICATION: N/A
- 7) WEIGHT: 45 lbs APPROX
- 8) WELD PER DART QSI 004
- 9) MASK HOLES PRIOR TO POWDER COAT
- 10) TRIM AS NECESSARY TO CLEAR FASTENERS/STRUCTURE.

RELEASED
2012-07-12
PCN 12-61

E	ADD D4672-1 (ZN D5-1, D6-1, C6-1, D3-2, D5-2, B4-6, C3-6, D6-6, C2-7, AND C5-7). REASON: PART12:197.	MB	12.06.18
D	UPDATED 73.75" DIMENSION ON (A4-10); ADDED DIM 10.66" (B6-6, B8-10)	SC	11.02.09
C	ADDITIONAL HOLES ADDED ON D4034-041 RIB ASSY: D3916-041 RIB ASSY IS REPLACED WITH D4306-043/-044 & D4306-045; ADDED D4277-19 RIB; UPDATED SECTION B-B, C-C, E-E, K-K, L-L; ADDED SECTION AE-AE ON SHT 2; UPDATED D4278-041/-047	SC	10.12.23
B	REDESIGN: ADD (1) D4021-1, (1) D4279-7, (1) D4279-11 (D6-1, D6-8); RMV D4277-17, D4278-043 (SHT 4.9); ADD (1) D3916-1, (2) D4277-5, (1) D4277-9, (1) D4306-1 (D6-4, D6-9), RMV (1) D4277-3 (D6-4, D6-9); 24.25 WAS 20.25 (A5-5, A5-10)	CP	10.11.30
A	NEW ISSUE	SC	10.11.25
REV.	DESCRIPTION	BY	DATE
DESIGN	JPH	DART AEROSPACE LTD HAWKESBURY, ONTARIO, CANADA DRAWING NO. D4273 REV. E SHEET 1 OF 10 TITLE BASKET BASE ASSY SCALE NTS COPYRIGHT © 2010 BY DART AEROSPACE LTD THIS DOCUMENT IS PRIVATE AND CONFIDENTIAL, AND IS SUPPLIED ON THE EXPRESS CONDITION THAT IT IS NOT TO BE USED FOR ANY PURPOSE OR COPIED OR REPRODUCED IN ANY MANNER WITHOUT WRITTEN PERMISSION FROM DART AEROSPACE LTD.	
DRAWN			
CHECKED			
MFG. APPR.			
APPROVED			
DE APPR.		DATE 12.06.18	

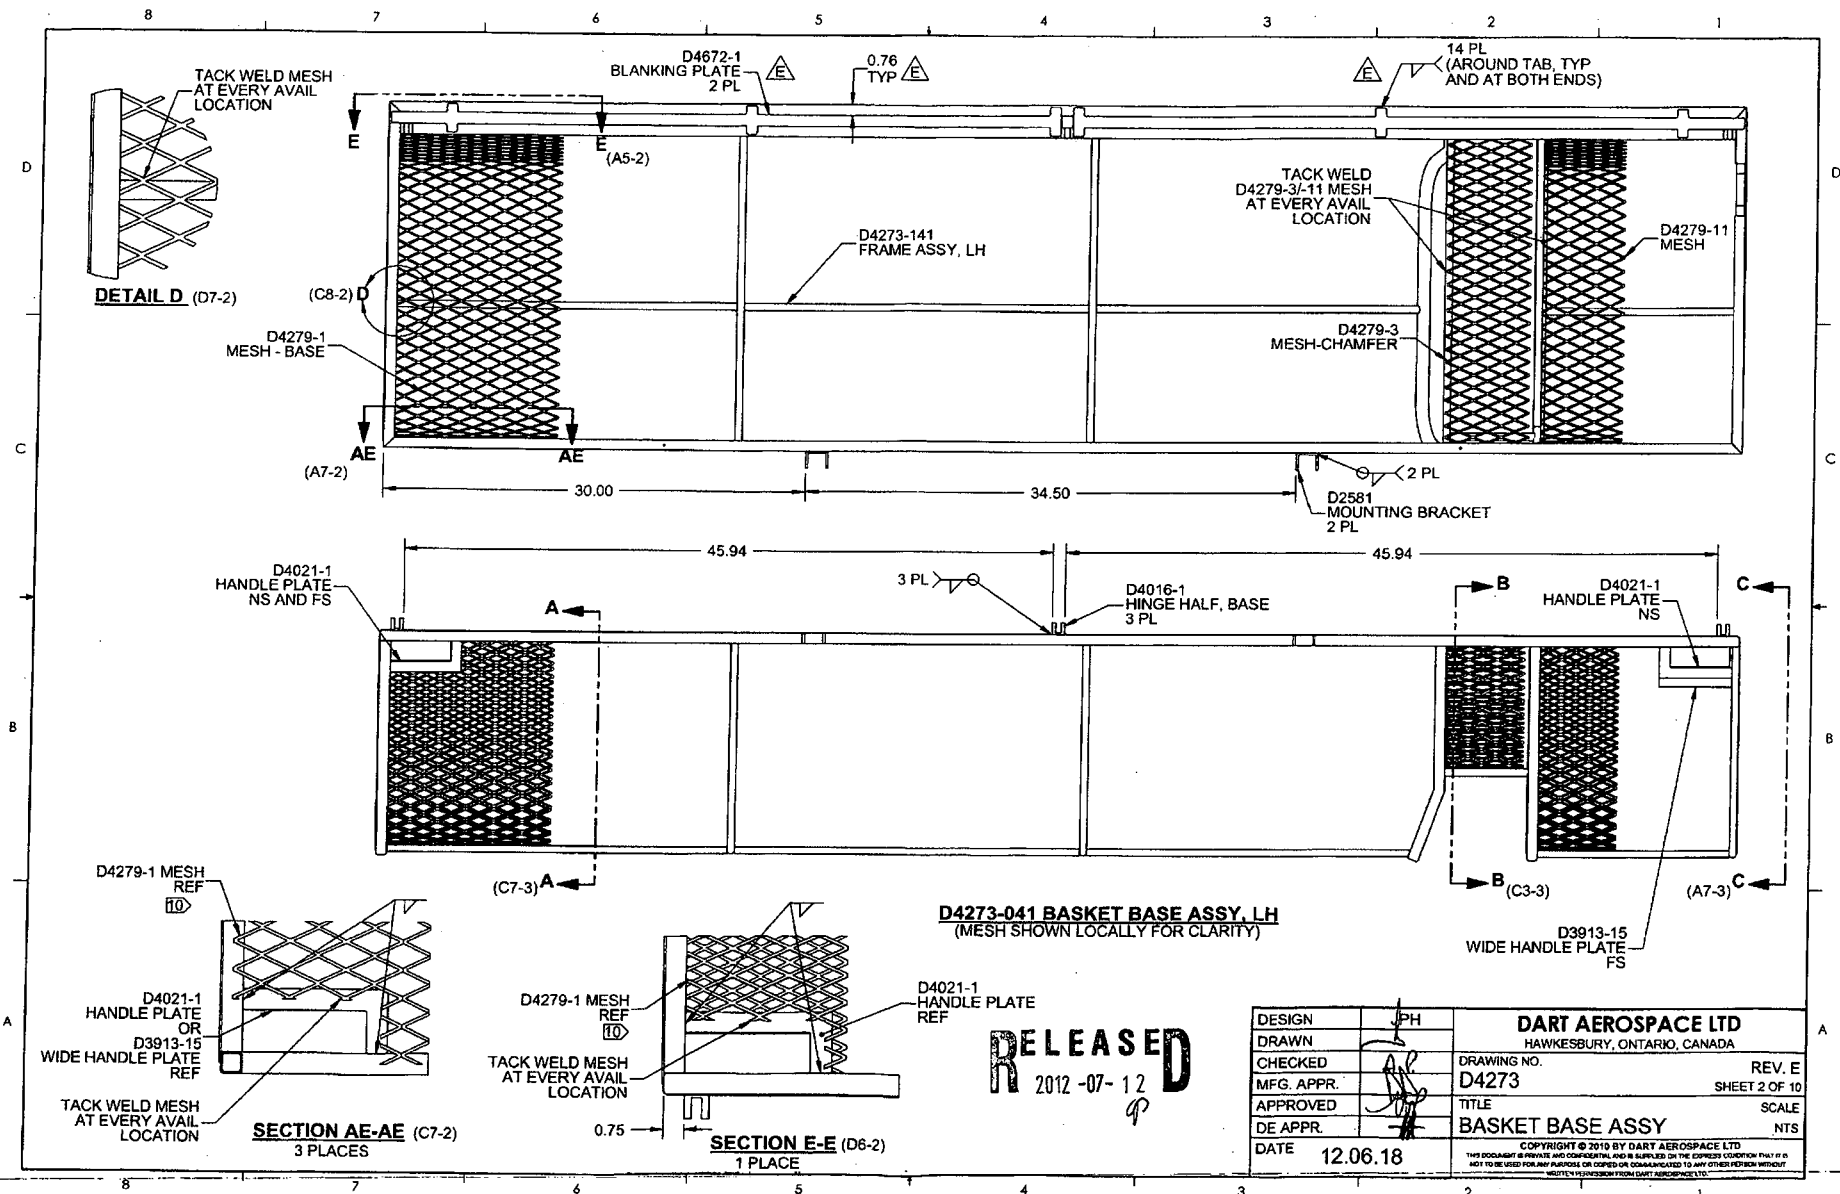


RELEASED
2012-07-12
P

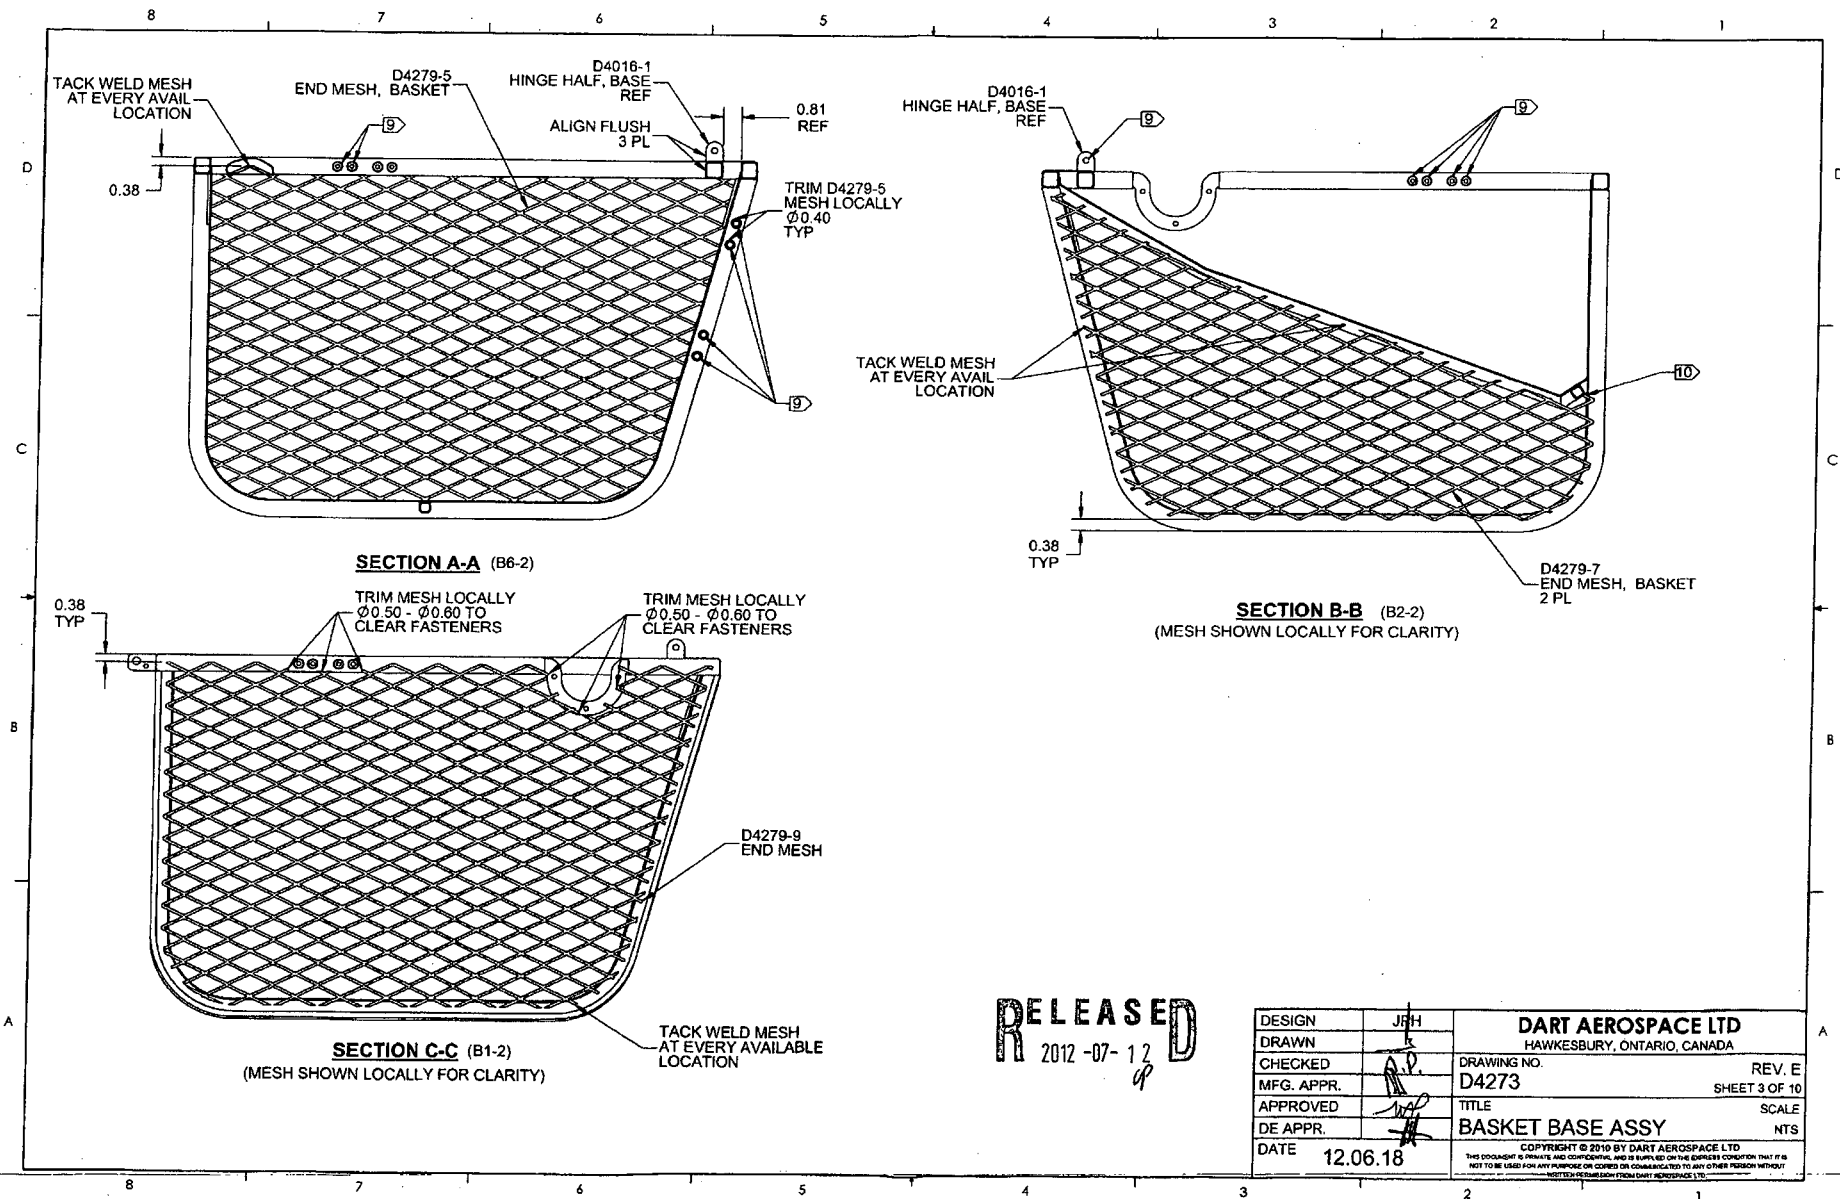

RELEASED
2012-07-12

DESIGN	JFH	DART AEROSPACE LTD	
DRAWN		HAWKESBURY, ONTARIO, CANADA	
CHECKED		DRAWING NO.	REV. E
MFG. APPR.		D4273	SHEET 3 OF 10
APPROVED		TITLE	SCALE
DE APPR.		BASKET BASE ASSY	NTS
DATE	12.06.18	COPYRIGHT © 2010 BY DART AEROSPACE LTD	
THIS DOCUMENT IS PRIVATE AND CONFIDENTIAL, AND IS SUPPLIED ON THE EMPLOYEE'S CORPORAION THAT IT IS NOT TO BE USED FOR ANY PURPOSE OR COMMUNICATED TO ANY OTHER PERSON WITHOUT THE WRITTEN PERMISSION FROM DART AEROSPACE LTD.			


ITEM	QTY	PART NUMBER	DESCRIPTION
	X	D4273-141	BASKET FRAME ASSY, LH
1	1	D3913-1	RIB
2	1	D3913-3	RIB
3	1	D3913-9	HINGE RIB
4	3	D3916-5	LIGHT RIB
5	1	D4017-7	RIB
6	1	D4034-041	AFT UPPER RIB ASSY
7	1	D4277-3	RIB
8	2	D4277-5	RIB
9	1	D4277-9	RIB
10	1	D4277-19	RIB
11	2	D4278-045	RIB ASSY, FWD CHAM
12	1	D4278-047	UPPER RIB ASSY-STRAIGHT
13	1	D4306-1	RIB
14	1	D4306-043	RIB ASSY, LH
15	1	D4306-045	RIB ASSY

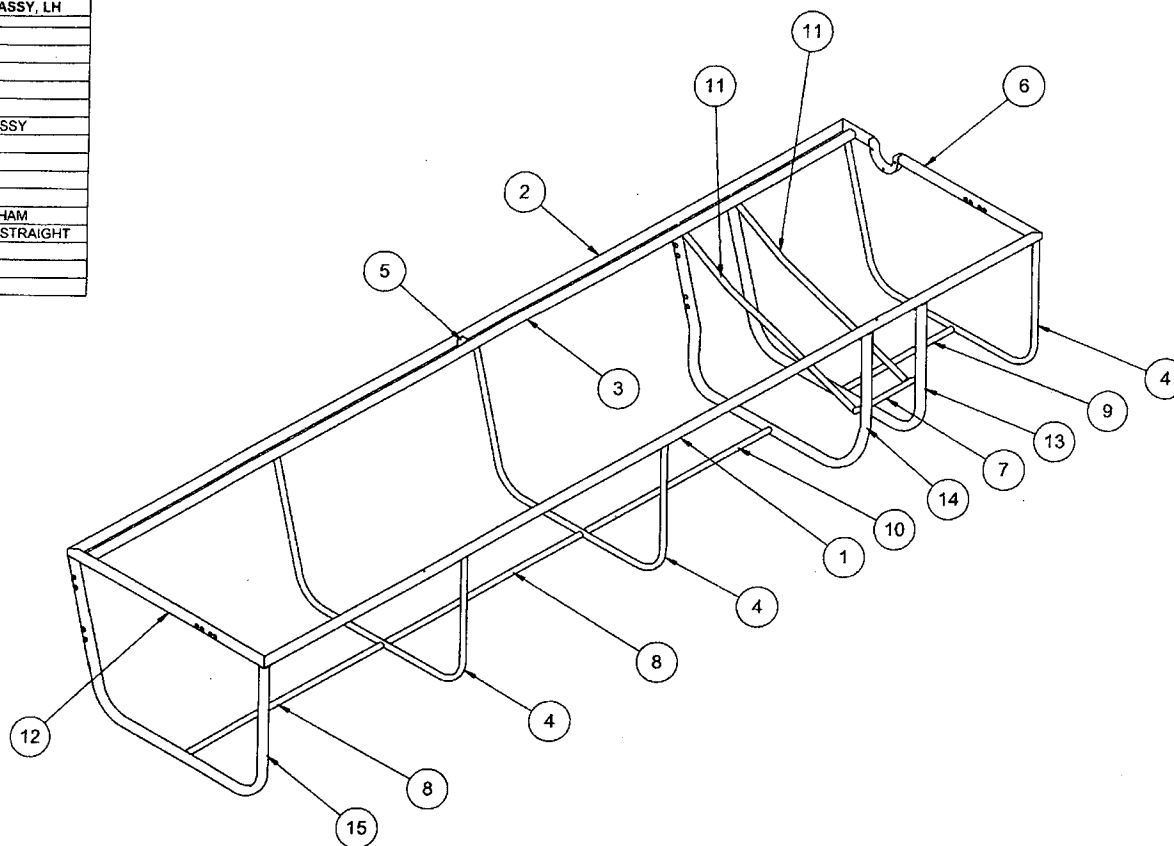


D4273-141 BASKET FRAME ASSY, LH

RELEASED
2012-07-12
GP

DESIGN	JFH	DART AEROSPACE LTD	
DRAWN		HAWKESBURY, ONTARIO, CANADA	
CHECKED	AP	DRAWING NO.	REV. E
MFG. APPR.		D4273	SHEET 4 OF 10
APPROVED		TITLE	SCALE
DE APPR.		BASKET BASE ASSY	NTS
DATE	12.06.18	COPYRIGHT © 2010 BY DART AEROSPACE LTD THIS DOCUMENT IS PRIVATE AND CONFIDENTIAL AND IS SUPPLIED ON THE EXPRESS CONDITION THAT IT IS NOT TO BE USED FOR ANY PURPOSE OR COPIED OR COMMUNICATED TO ANY OTHER PERSON WITHOUT THE WRITTEN PERMISSION OF DART AEROSPACE LTD.	

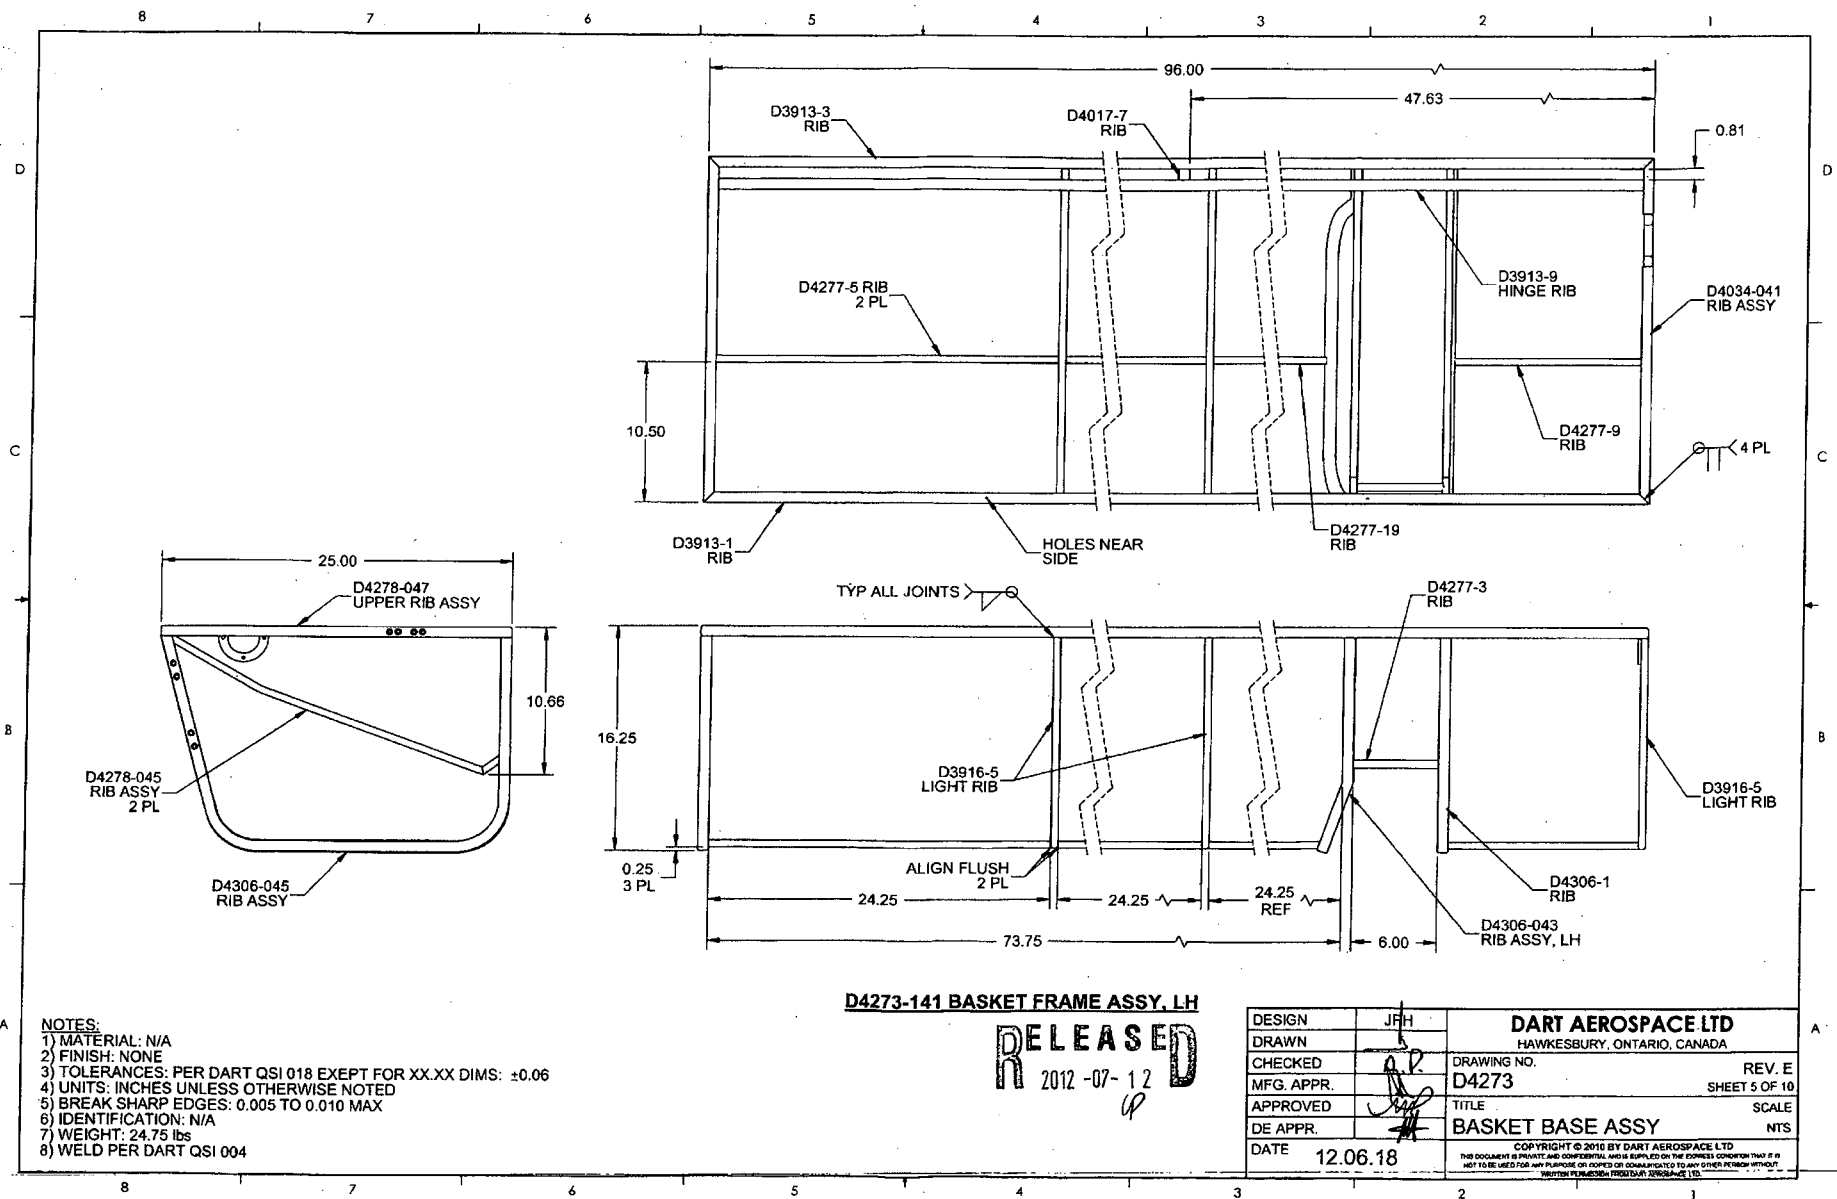

ITEM	QTY	P/N	DESCRIPTION
	X	D4273-042	BASKET BASE ASSY, RH
1	2	D2581	MOUNTING BRACKET
2	1	D3913-15	WIDE HANDLE PLATE
3	3	D4016-1	HINGE HALF, BASE
4	3	D4021-1	HANDLE PLATE
5	1	D4273-142	BASKET FRAME ASSY, RH
6	1	D4279-1	MESH - BASE
7	1	D4279-3	MESH - CHAMFER
8	1	D4279-5	END MESH, BASKET
9	2	D4279-7	END MESH, BASKET
10	1	D4279-9	END MESH, BASKET
11	1	D4279-11	MESH - BASE
12	2	D4672-1	BLANKING PLATE

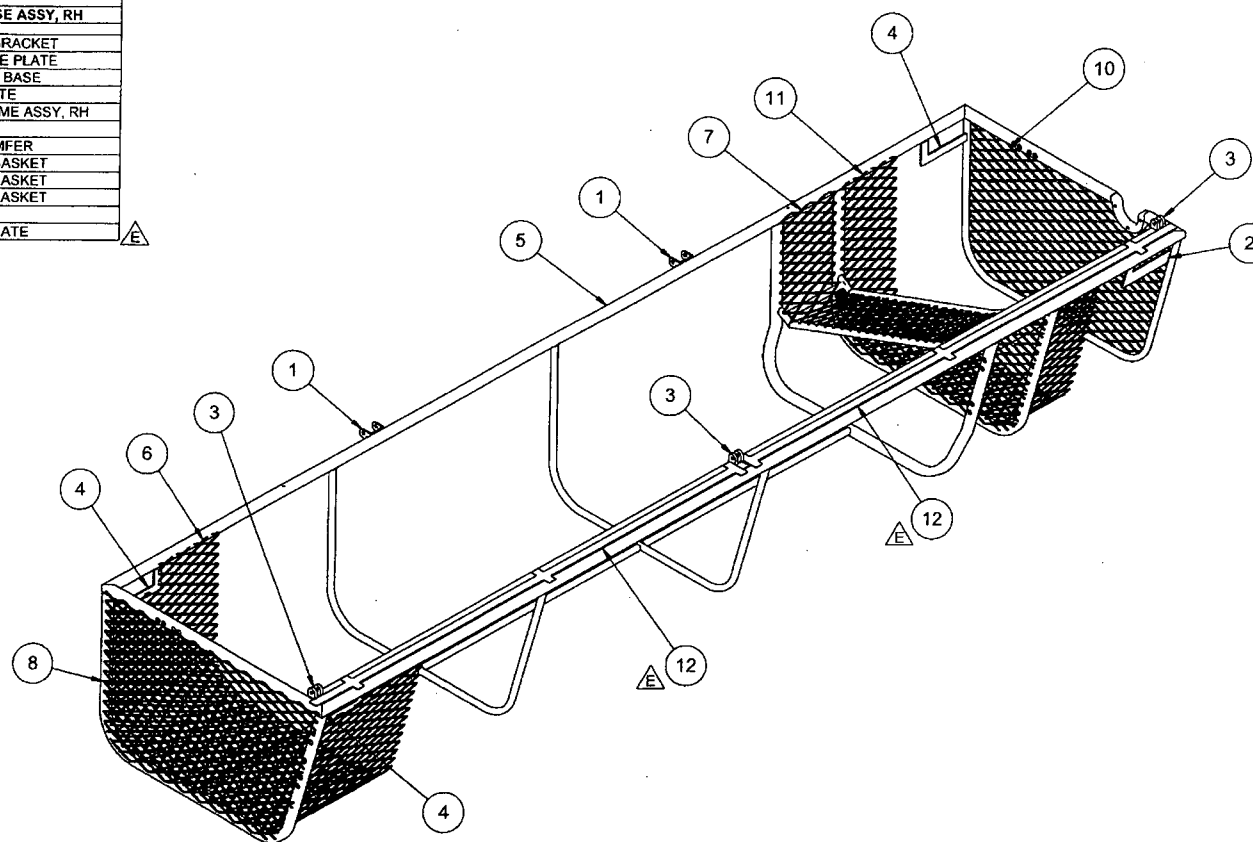

D4273-042 BASKET BASE ASSY, RH
(MESH SHOWN LOCALLY FOR CLARITY)


NOTES:


- 1) MATERIAL: N/A
- 2) FINISH: POWDER COAT WHITE (4.3.5.2) PER DART QSI 005 4.3
- 3) TOLERANCES: PER DART QSI 018 UNLESS OTHERWISE NOTED
- 4) UNITS: INCHES UNLESS OTHERWISE NOTED
- 5) BREAK SHARP EDGES: N/A
- 6) IDENTIFICATION: N/A
- 7) WEIGHT: 45 lbs APPROX
- 8) WELD PER DART QSI 004
- 9) MASK HOLES PRIOR TO POWDER COAT
- 10) TRIM AS NECESSARY TO CLEAR FASTENERS/STRUCTURE.

RELEASED
2012-07-12
CP


DESIGN	JPH	DART AEROSPACE LTD	
DRAWN		HAWKESBURY, ONTARIO, CANADA	
CHECKED		DRAWING NO. D4273	REV. E
MFG. APPR.			SHEET 6 OF 10
APPROVED		TITLE BASKET BASE ASSY	SCALE
DE APPR.			NTS
DATE	12.06.18	COPYRIGHT © 2010 BY DART AEROSPACE LTD THIS DOCUMENT IS PRIVATE AND CONFIDENTIAL AND IS LOANED ON THE EXPRESS UNDERSTANDING THAT IT IS NOT TO BE USED FOR ANY PURPOSE OR DISSEMINATED TO ANY OTHER PERSON WITHOUT WRITTEN PERMISSION FROM DART AEROSPACE LTD.	

RELEASED
2012-07-12

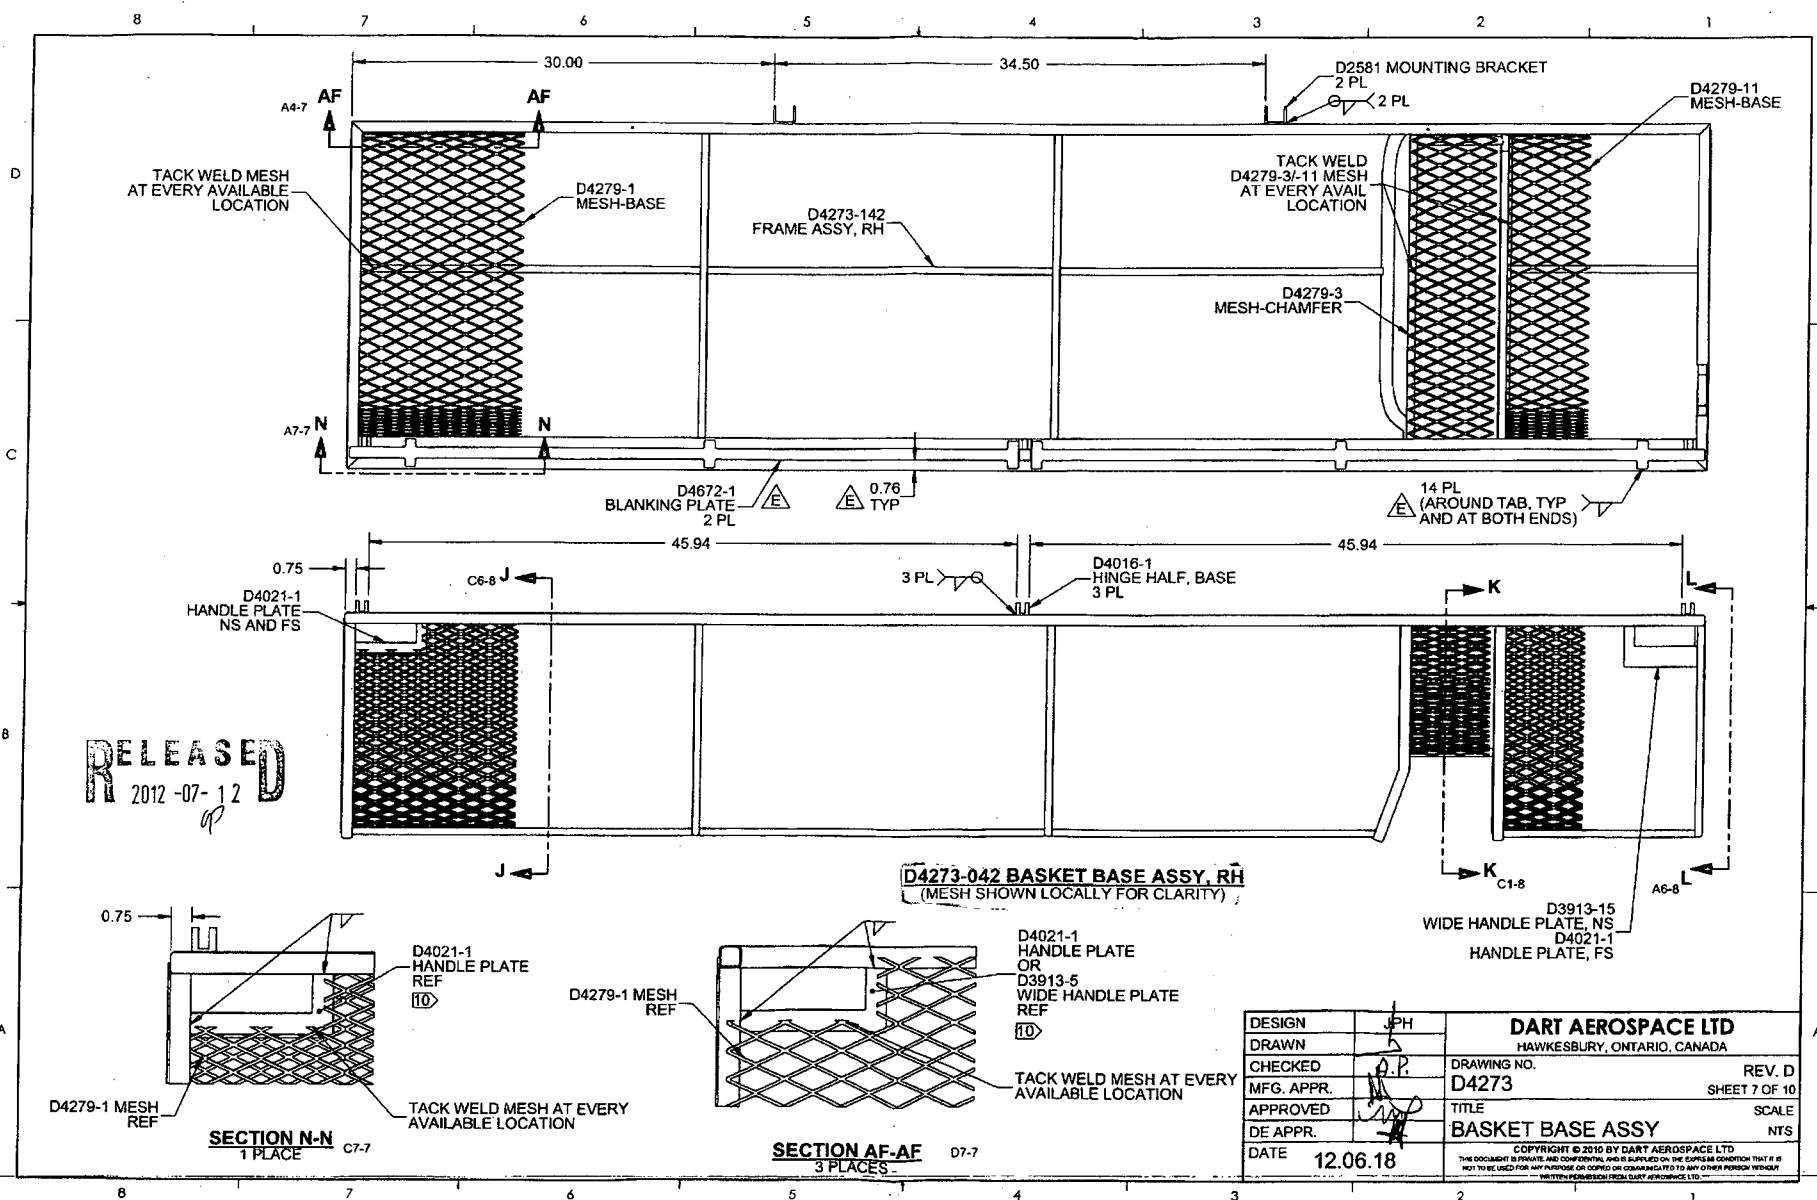


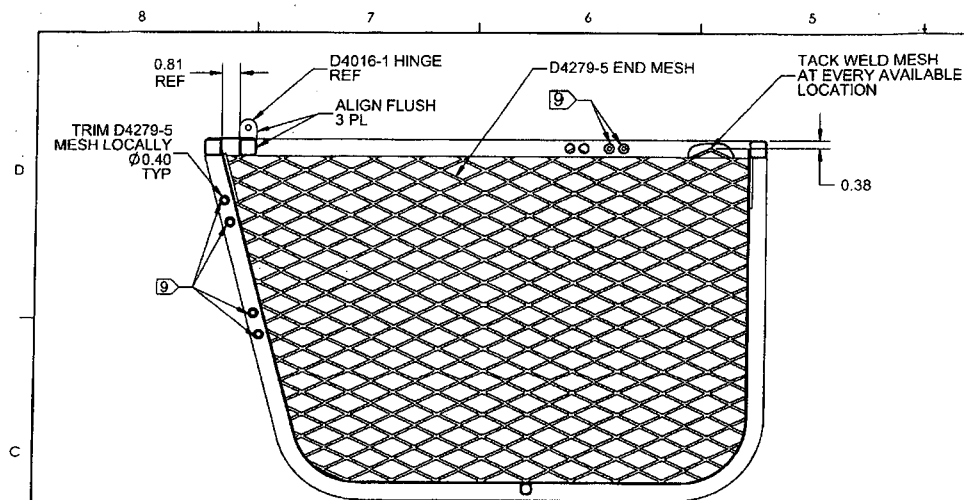

SECTION J-J C6-7

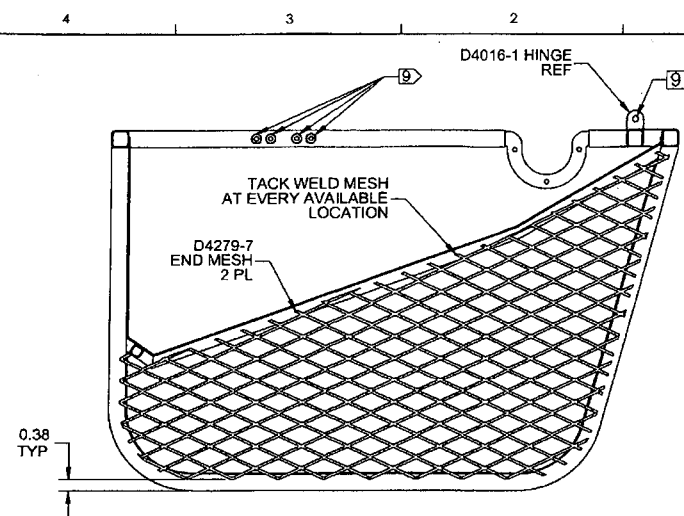

SECTION K-K B2-7
(MESH SHOWN LOCALLY FOR CLARITY)

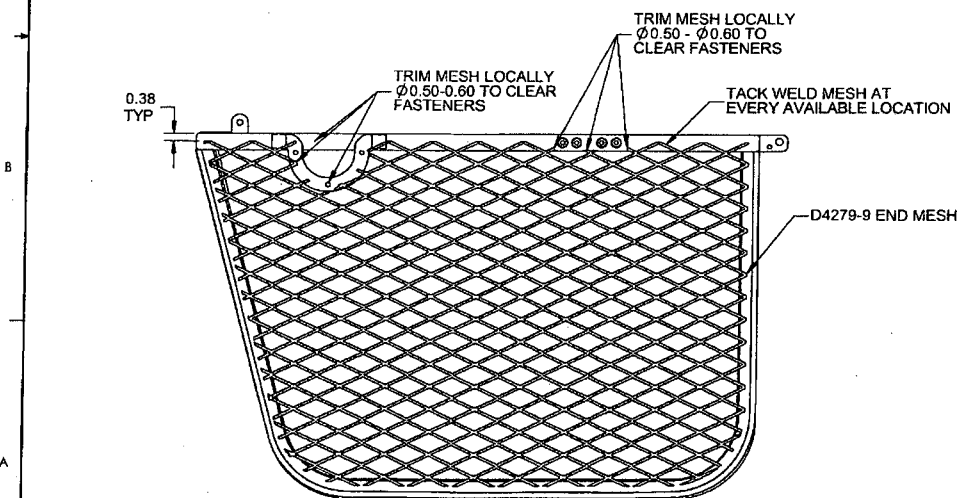


SECTION L-L B1-7
(MESH SHOWN LOCALLY FOR CLARITY)

RELEASED
2012-07-12
CP

DESIGN	JPH	DART AEROSPACE LTD	
DRAWN		HAWKESBURY, ONTARIO, CANADA	
CHECKED		DRAWING NO.	REV. E
MFG. APPR.		D4273	SHEET 8 OF 10
APPROVED		TITLE	SCALE
DE APPR.		BASKET BASE ASSY	NTS
DATE	12.06.18	COPYRIGHT © 2010 BY DART AEROSPACE LTD	
THIS DOCUMENT IS PRIVATE AND CONFIDENTIAL. AND IS SUPPLIED ON THE EXPRESS CONDITION THAT IT IS NOT TO BE USED FOR ANY PURPOSE OR COMMUNICATED TO ANY OTHER PERSON WITHOUT WRITTEN PERMISSION FROM DART AEROSPACE LTD.			


ITEM	QTY	PART NUMBER	DESCRIPTION
	X	D4273-142	BASKET FRAME ASSY, RH
1	1	D3913-1	RIB
2	1	D3913-3	RIB
3	1	D3913-9	HINGE RIB
4	3	D3916-5	LIGHT RIB
5	3	D4017-7	RIB
6	1	D4277-3	RIB
7	2	D4277-5	RIB
8	1	D4277-9	RIB
9	1	D4277-19	RIB
10	1	D4278-041	UPPER RIB ASSY-HOOP
11	2	D4278-045	RIB ASSY, FWD CHAM
12	1	D4278-047	UPPER RIB ASSY-STRAIGHT
13	1	D4306-1	RIB
14	1	D4306-044	RIB ASSY, RH
15	1	D4306-045	RIB ASSY

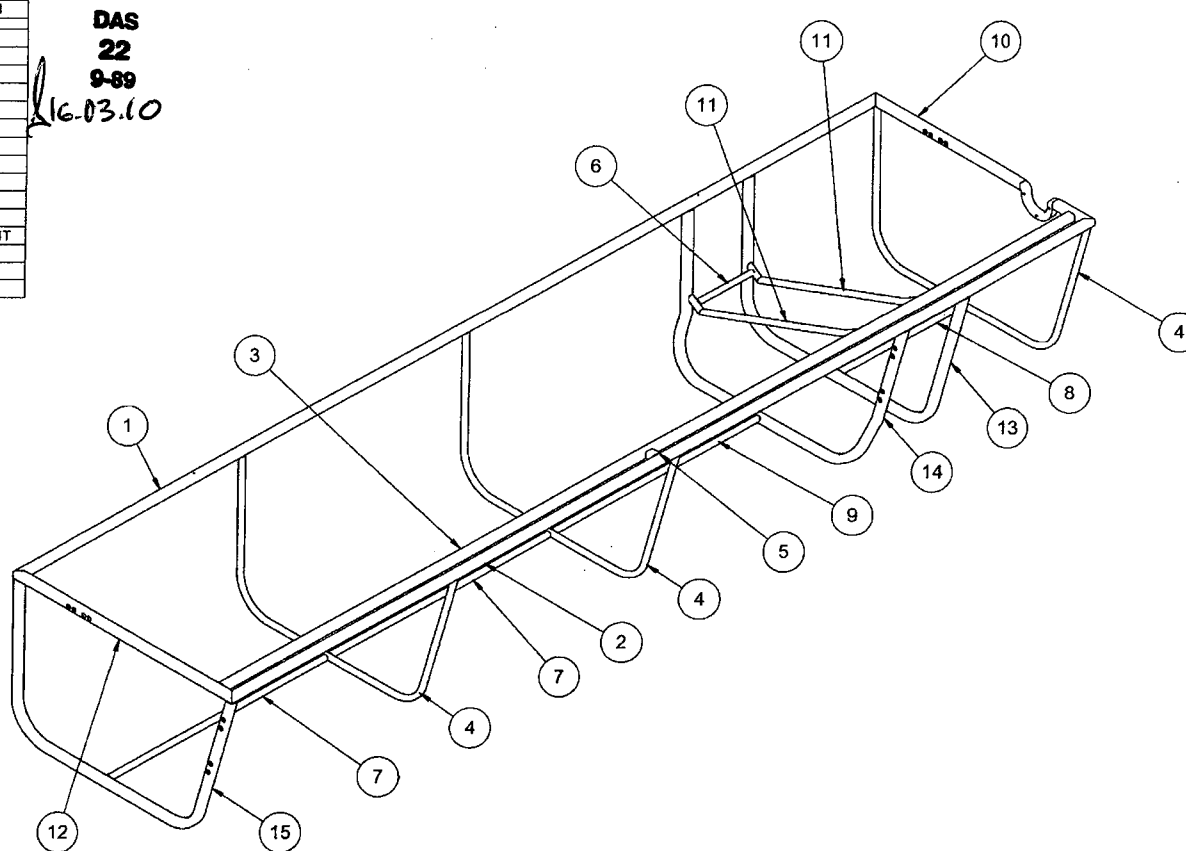



D4273-142 BASKET FRAME ASSY, RH


RELEASED
2012-07-12

DESIGN	JPH	DART AEROSPACE LTD	
DRAWN		HAWKESBURY, ONTARIO, CANADA	
CHECKED	A.V.	DRAWING NO.	REV. E
MFG. APPR.		D4273	SHEET 9 OF 10
APPROVED		TITLE	SCALE
DE APPR.		BASKET BASE ASSY	NTS
DATE	12.06.18	COPYRIGHT © 2010 BY DART AEROSPACE LTD THIS DOCUMENT IS PRIVATE AND CONFIDENTIAL AND IS SUPPLIED ON THE EXPRESS CONDITION THAT IT IS NOT TO BE USED FOR ANY PURPOSE OR COPIED OR COMMUNICATED TO ANY OTHER PERSON WITHOUT WRITTEN PERMISSION FROM DART AEROSPACE LTD.	

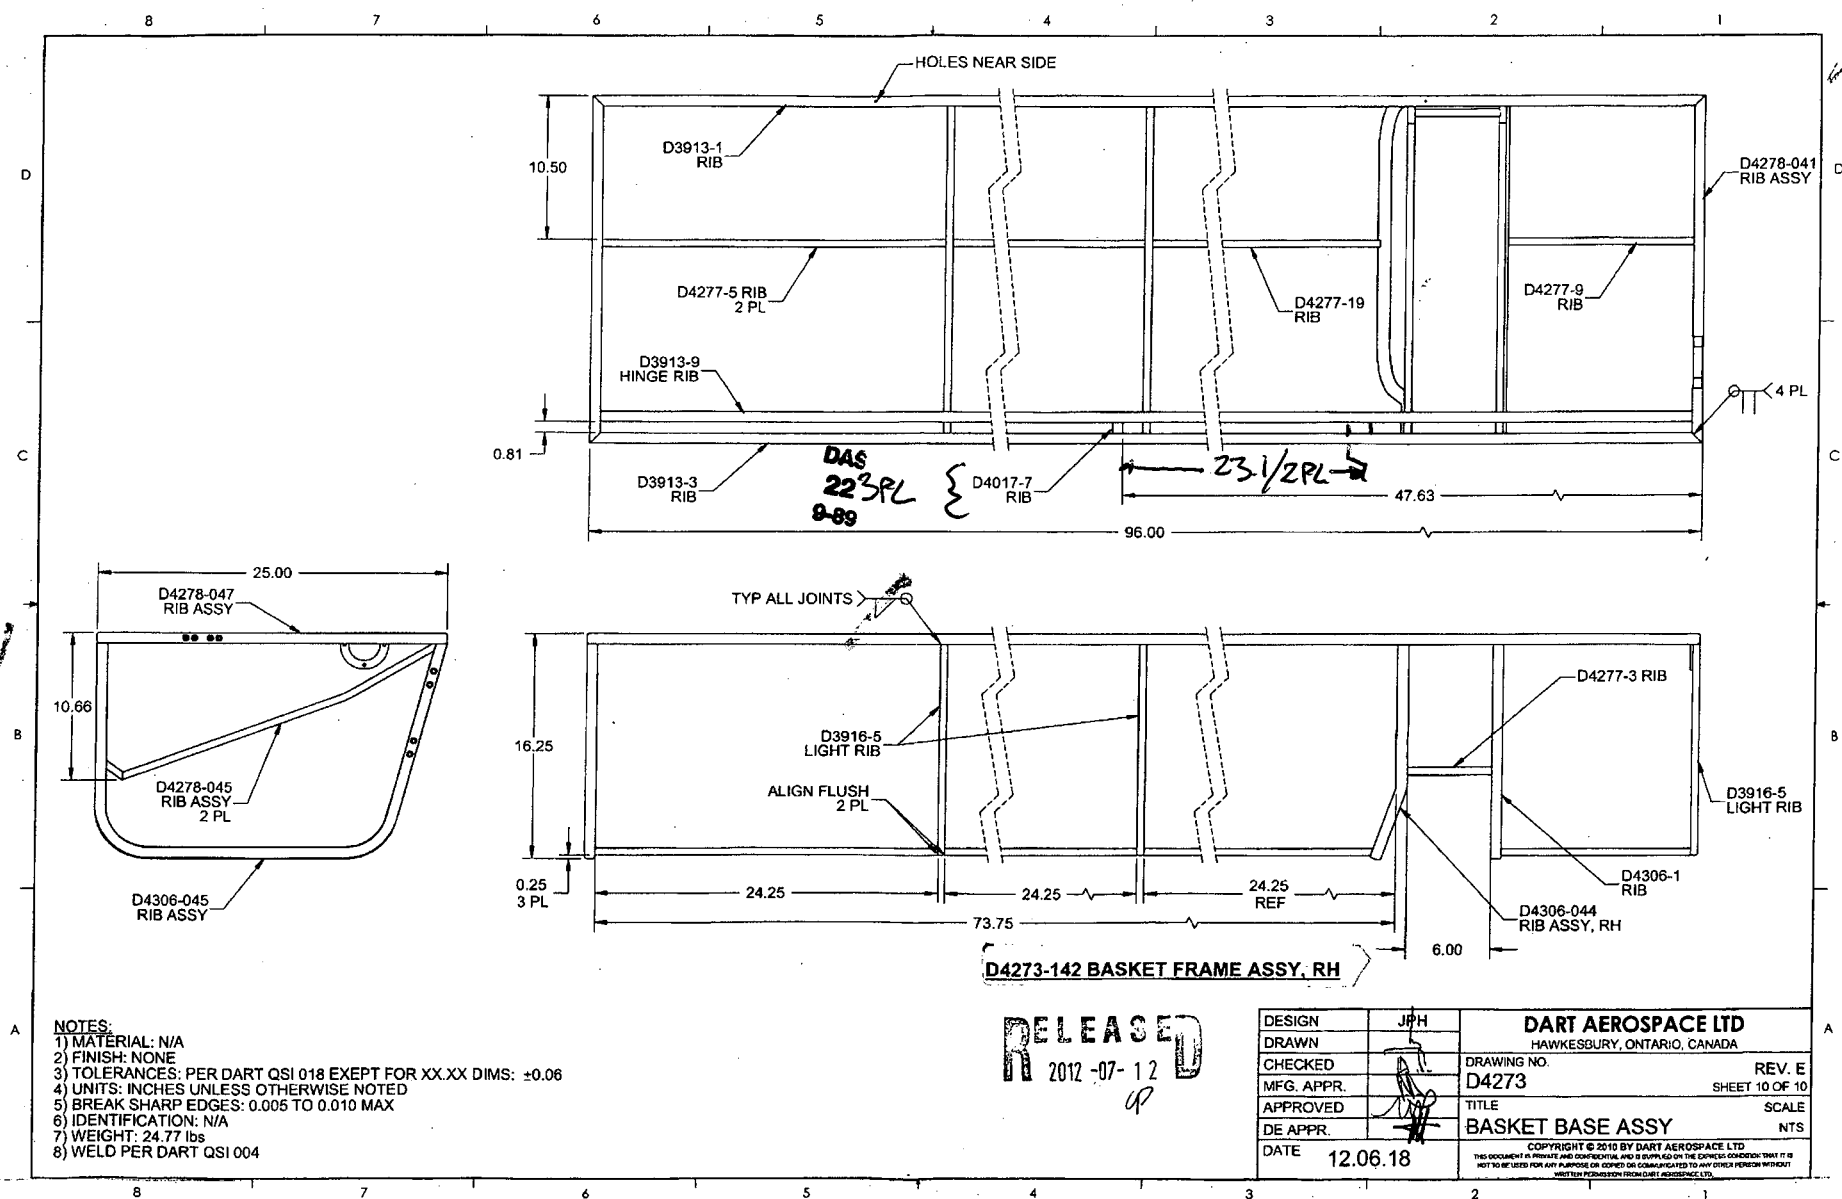

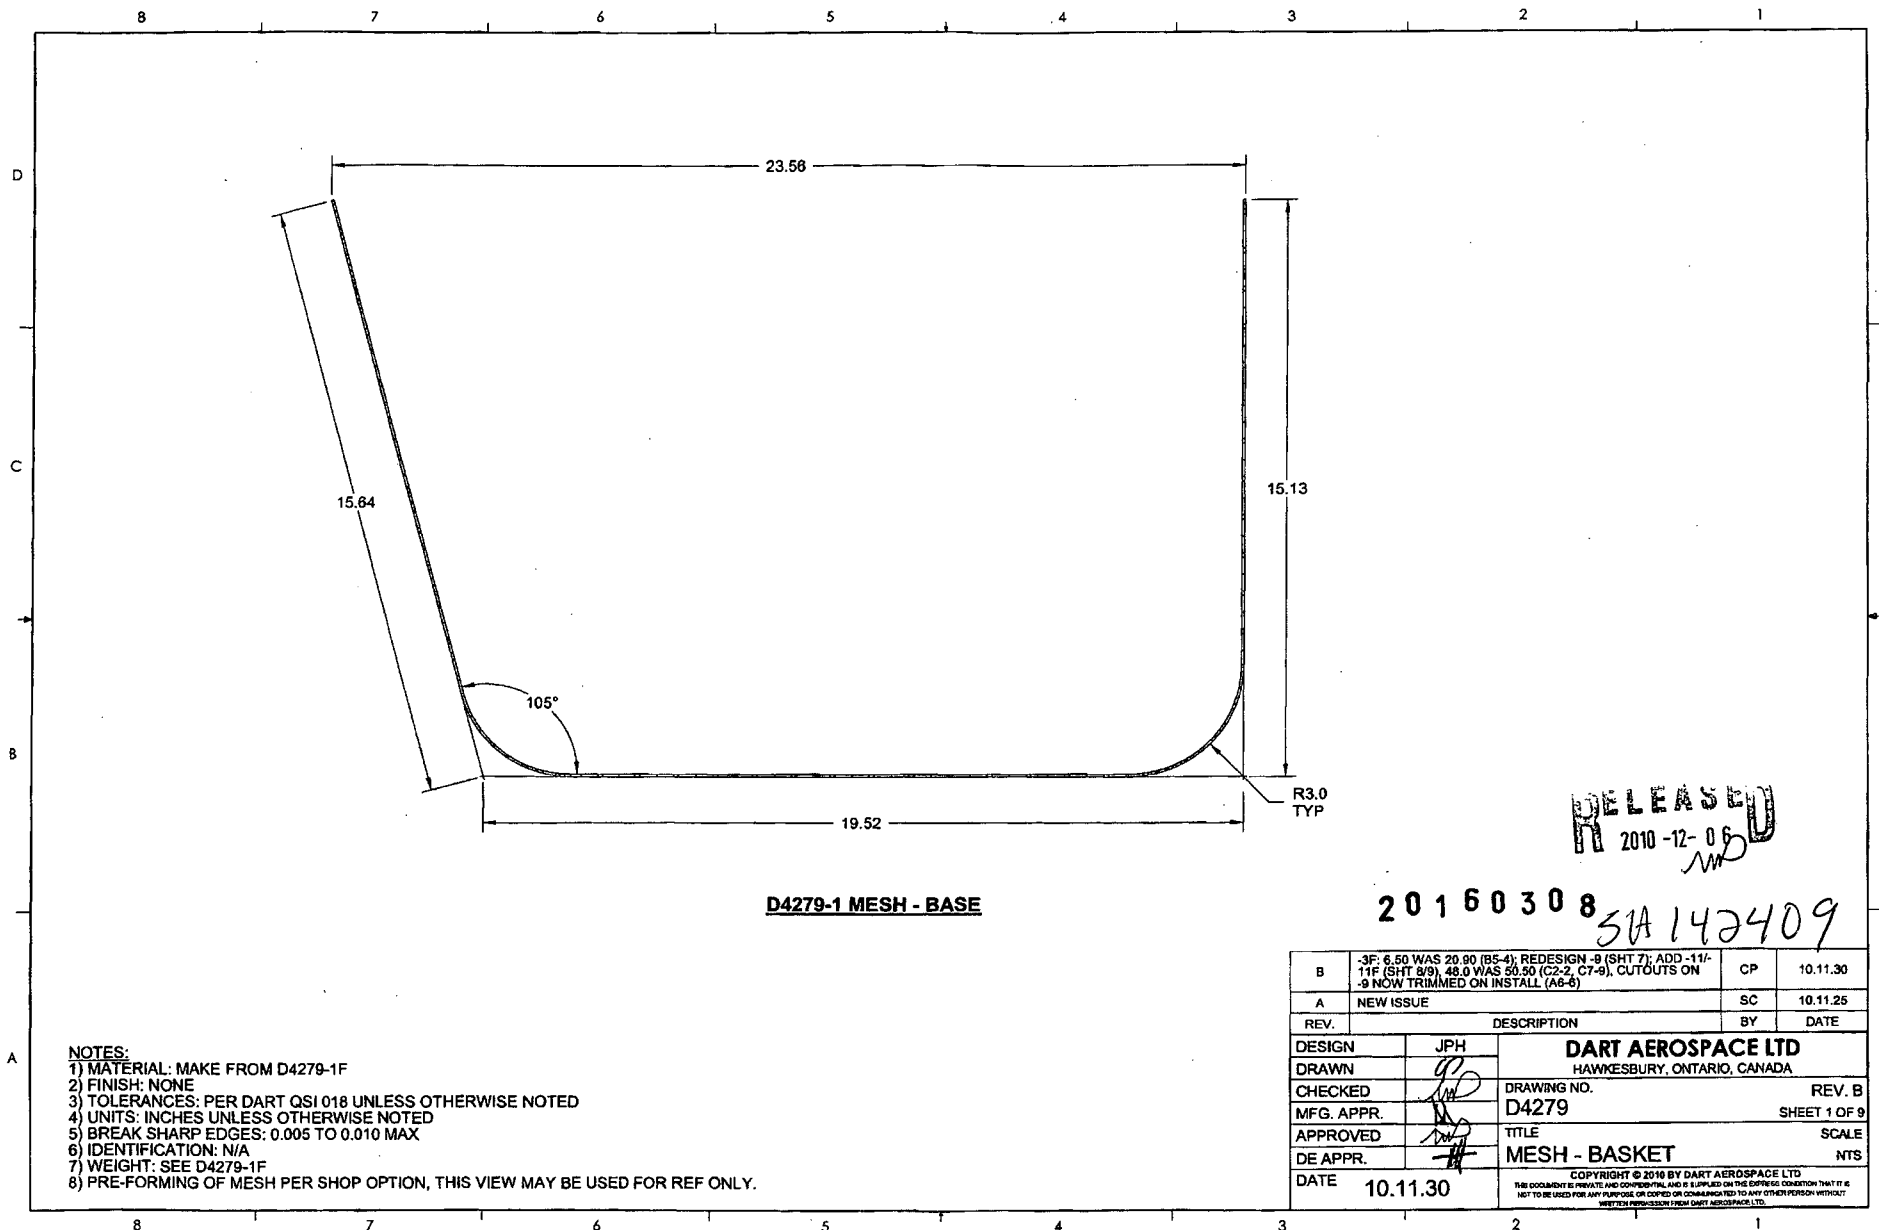

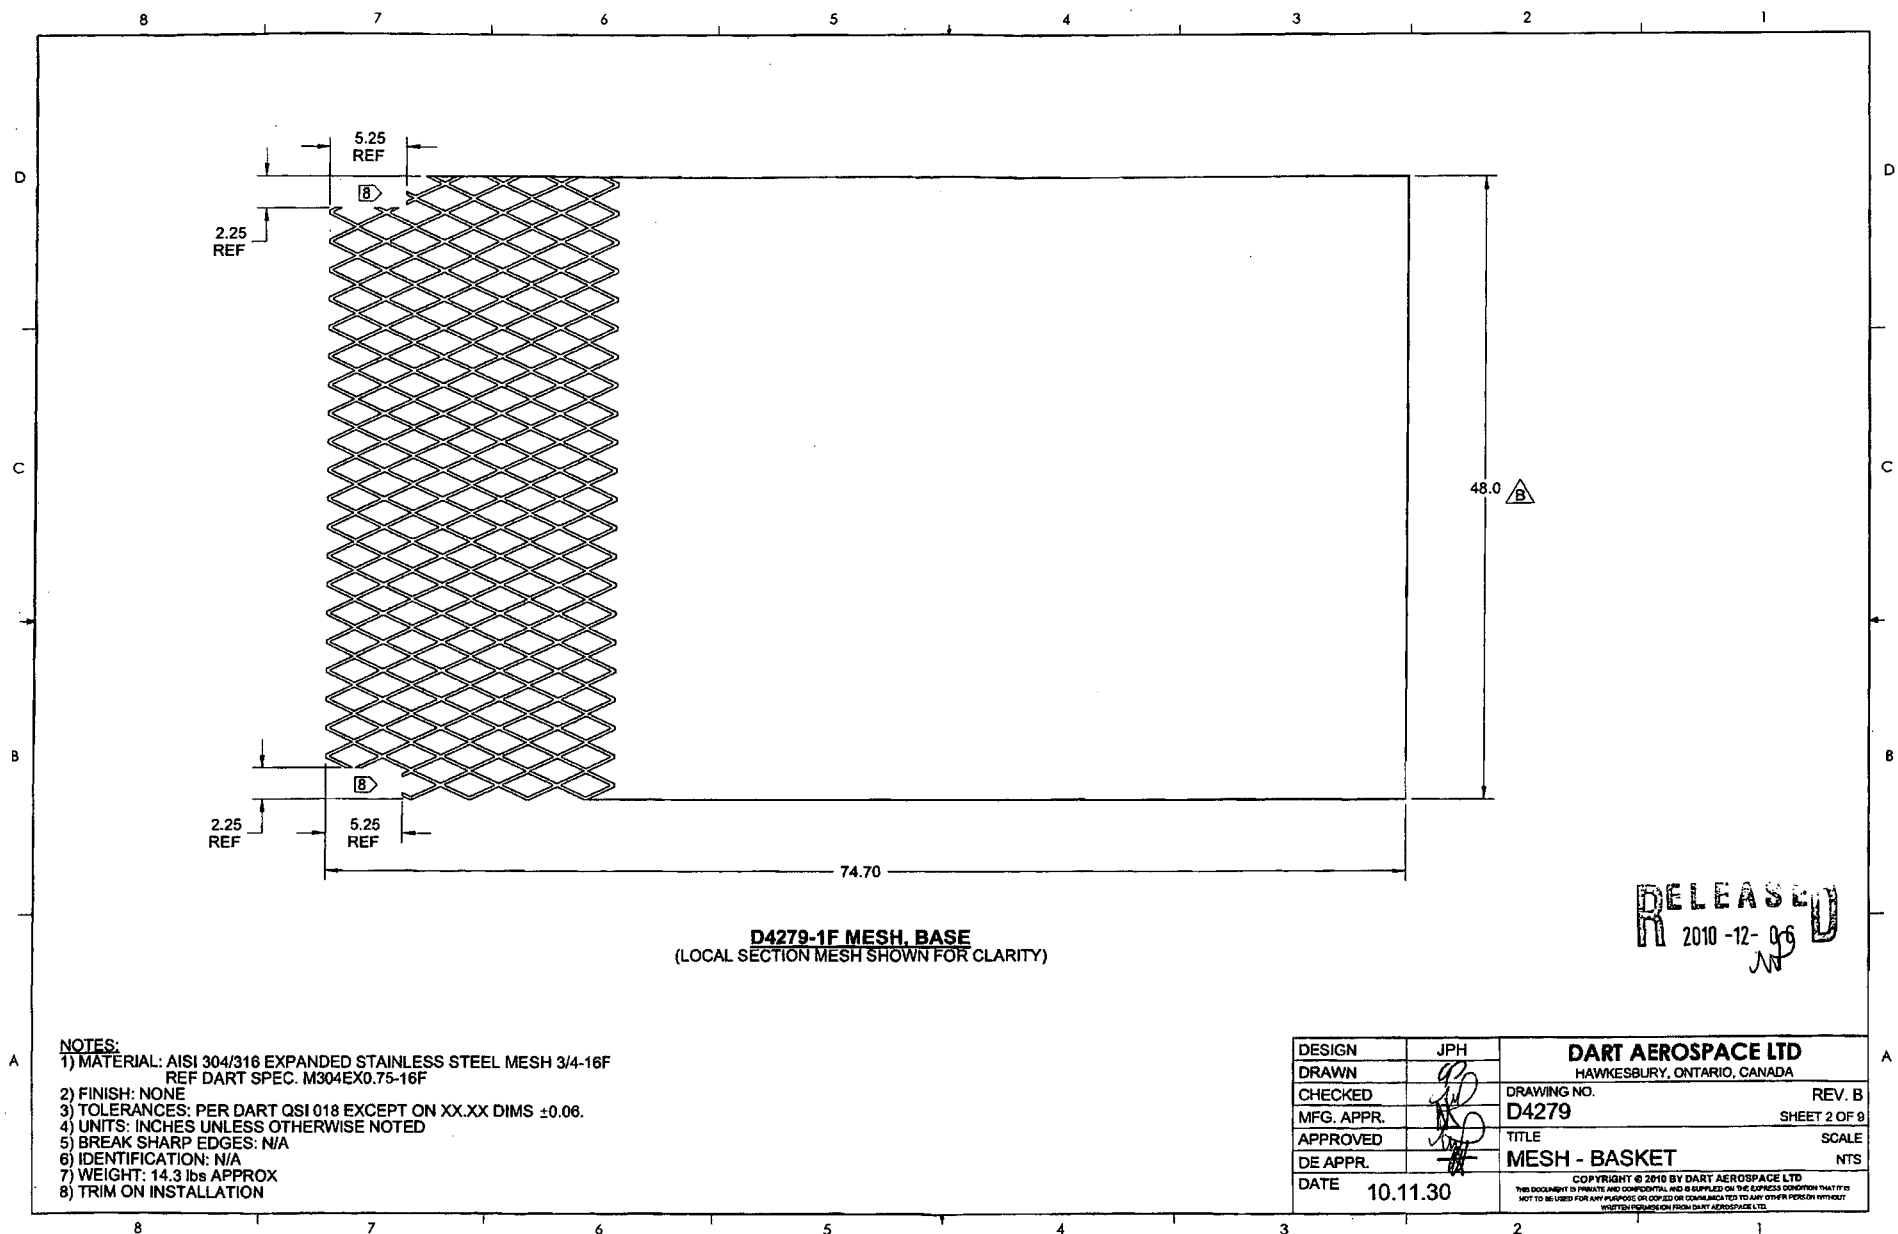

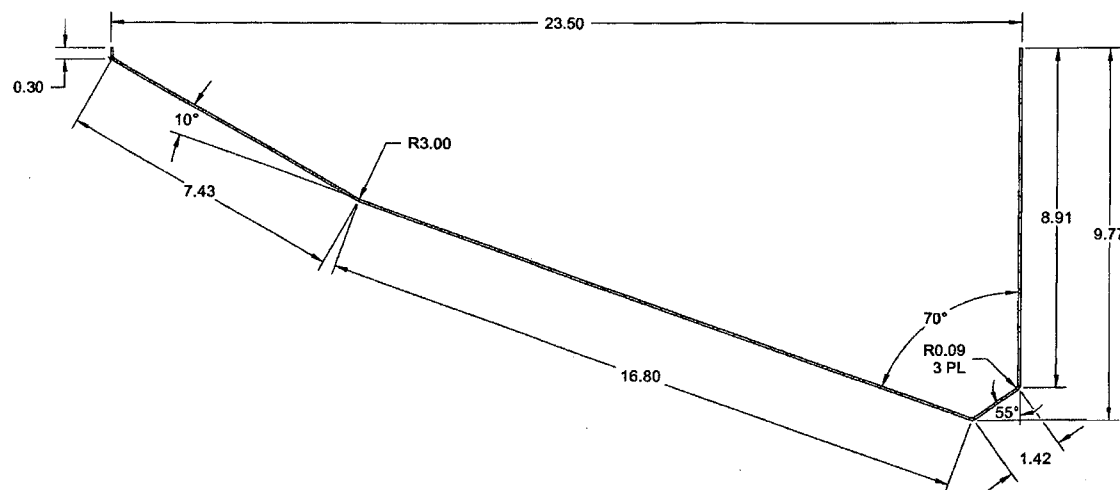


D4279-3 MESH-CHAMFER

RELEASED
2010-12-08

NOTES:

- 1) MATERIAL: MAKE FROM D4279-3F
- 2) FINISH: NONE
- 3) TOLERANCES: PER DART QSI 018 EXCEPT ON XX.XX DIMS ± 0.06 .
- 4) UNITS: INCHES UNLESS OTHERWISE NOTED
- 5) BREAK SHARP EDGES: N/A
- 6) IDENTIFICATION: N/A
- 7) WEIGHT: SEE D4279-3F
- 8) PRE-FORMING OF MESH PER SHOP OPTION, THIS VIEW MAY BE USED FOR REF ONLY.

DESIGN	JPH	DART AEROSPACE LTD	
DRAWN	<i>[Signature]</i>	HAWKESBURY, ONTARIO, CANADA	
CHECKED	<i>[Signature]</i>	DRAWING NO. D4279	REV. B
MFG. APPR.	<i>[Signature]</i>	SHEET 3 OF 9	
APPROVED	<i>[Signature]</i>	TITLE	SCALE
DE APPR.	<i>[Signature]</i>	MESH - BASKET	NTS
DATE	10.11.30	COPYRIGHT © 2010 BY DART AEROSPACE LTD THIS DOCUMENT IS PRIVATE AND CONFIDENTIAL AND IS SUPPLIED ON THE EXPRESS CONDITION THAT IT IS NOT TO BE USED FOR ANY PURPOSE OR COPIED OR COMMUNICATED TO ANY OTHER PERSON WITHOUT WRITTEN PERMISSION FROM DART AEROSPACE LTD.	

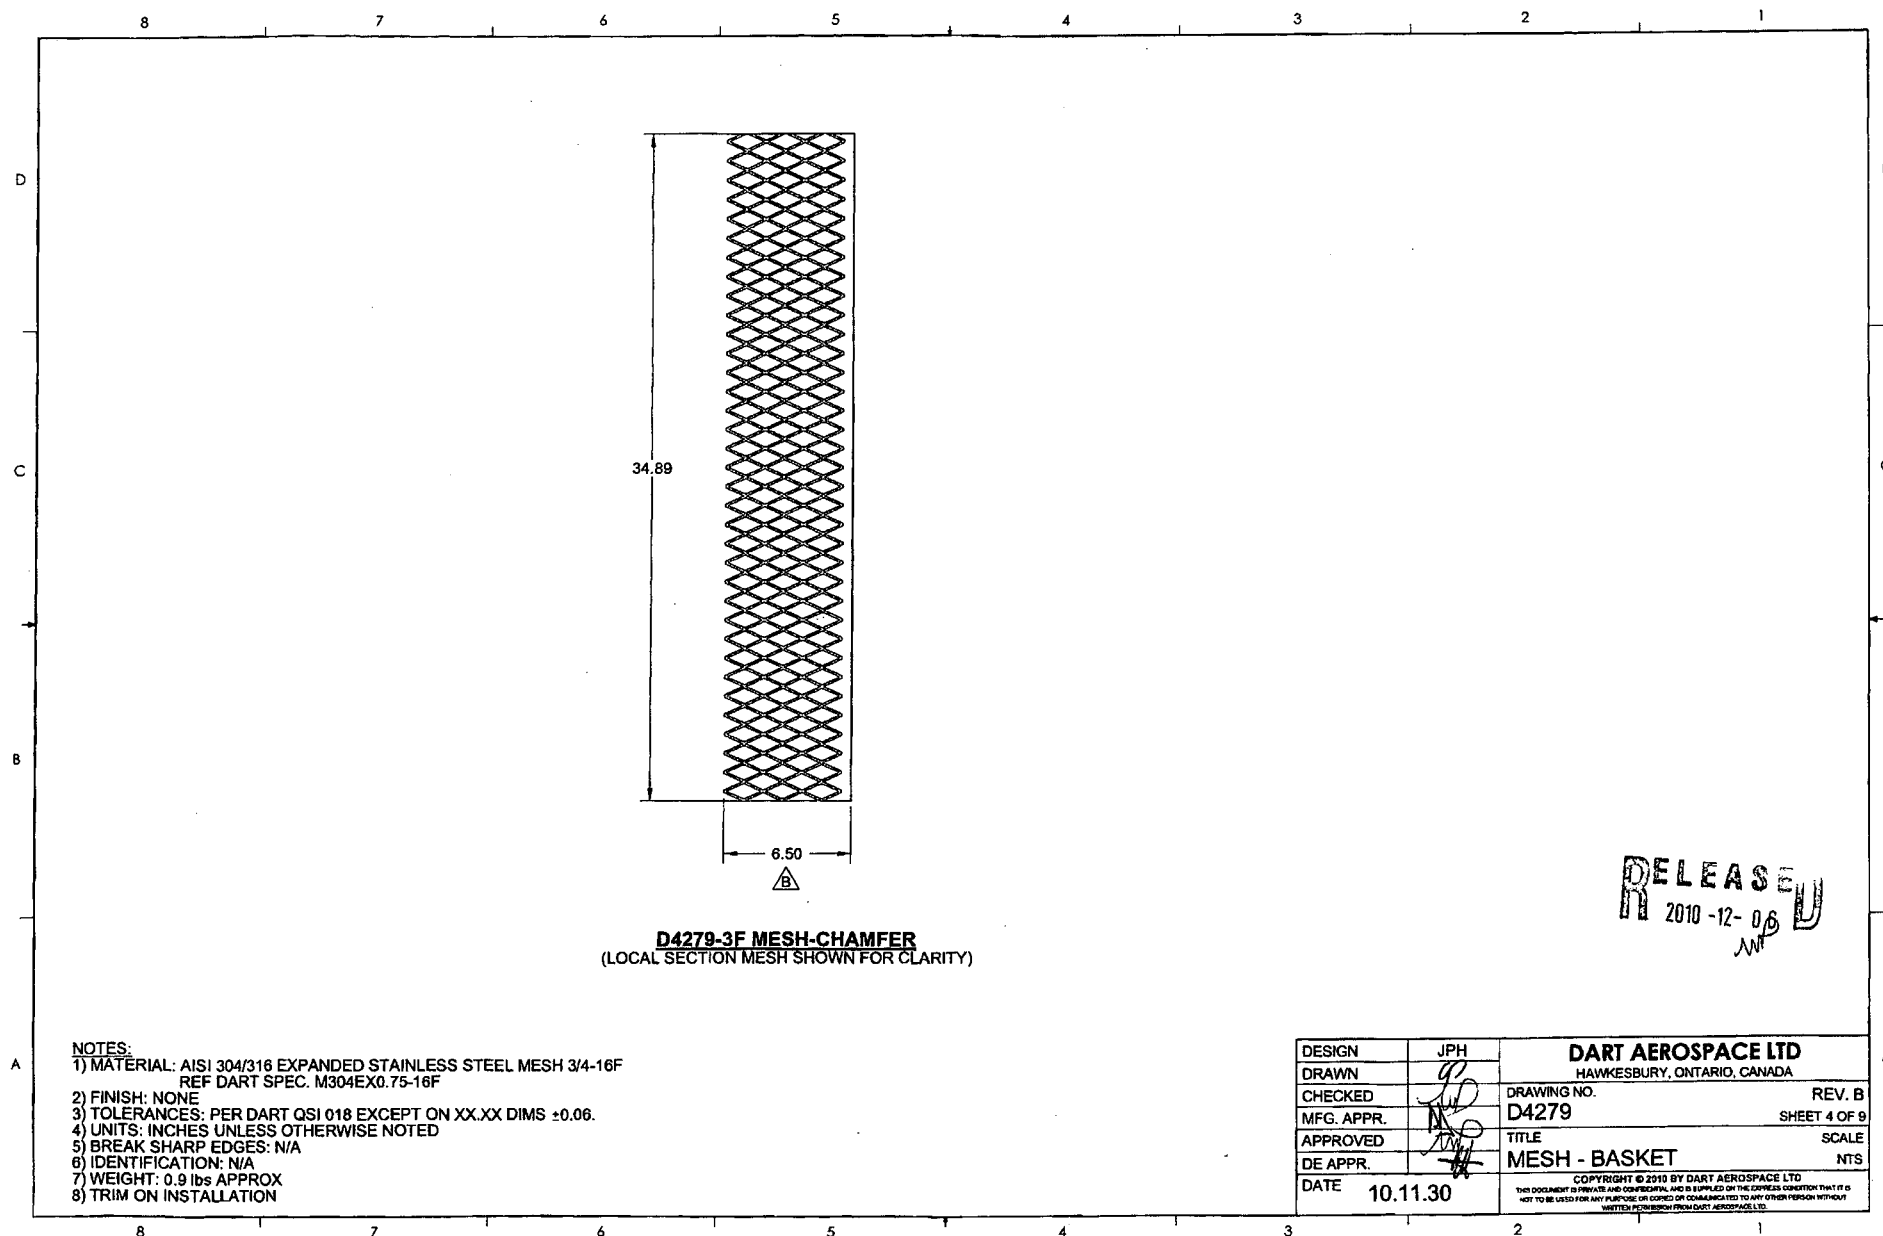



RELEASE
2010-12-06
JPH

NOTES:

- 1) MATERIAL: AISI 304/316 EXPANDED STAINLESS STEEL MESH 3/4-16F
REF DART SPEC. M304EX0.75-16F
- 2) FINISH: NONE
- 3) TOLERANCES: PER DART QSI 018 EXCEPT ON XX.XX DIMS ± 0.06 .
- 4) UNITS: INCHES UNLESS OTHERWISE NOTED
- 5) BREAK SHARP EDGES: N/A
- 6) IDENTIFICATION: N/A
- 7) WEIGHT: 0.9 lbs APPROX
- 8) TRIM ON INSTALLATION

DESIGN	JPH	DART AEROSPACE LTD	
DRAWN	JPH	HAWKESBURY, ONTARIO, CANADA	
CHECKED	JPH	DRAWING NO.	REV. B
MFG. APPR.	JPH	D4279	SHEET 4 OF 9
APPROVED	JPH	TITLE	SCALE
DE APPR.	JPH	MESH - BASKET	NTS
DATE	10.11.30	COPYRIGHT © 2010 BY DART AEROSPACE LTD THIS DOCUMENT IS PRIVATE AND CONFIDENTIAL, AND IS SUPPLIED ON THE EXPRESS CONDITION THAT IT IS NOT TO BE USED FOR ANY PURPOSE OR COMMUNICATED TO ANY OTHER PERSON WITHOUT WRITTEN PERMISSION FROM DART AEROSPACE LTD.	

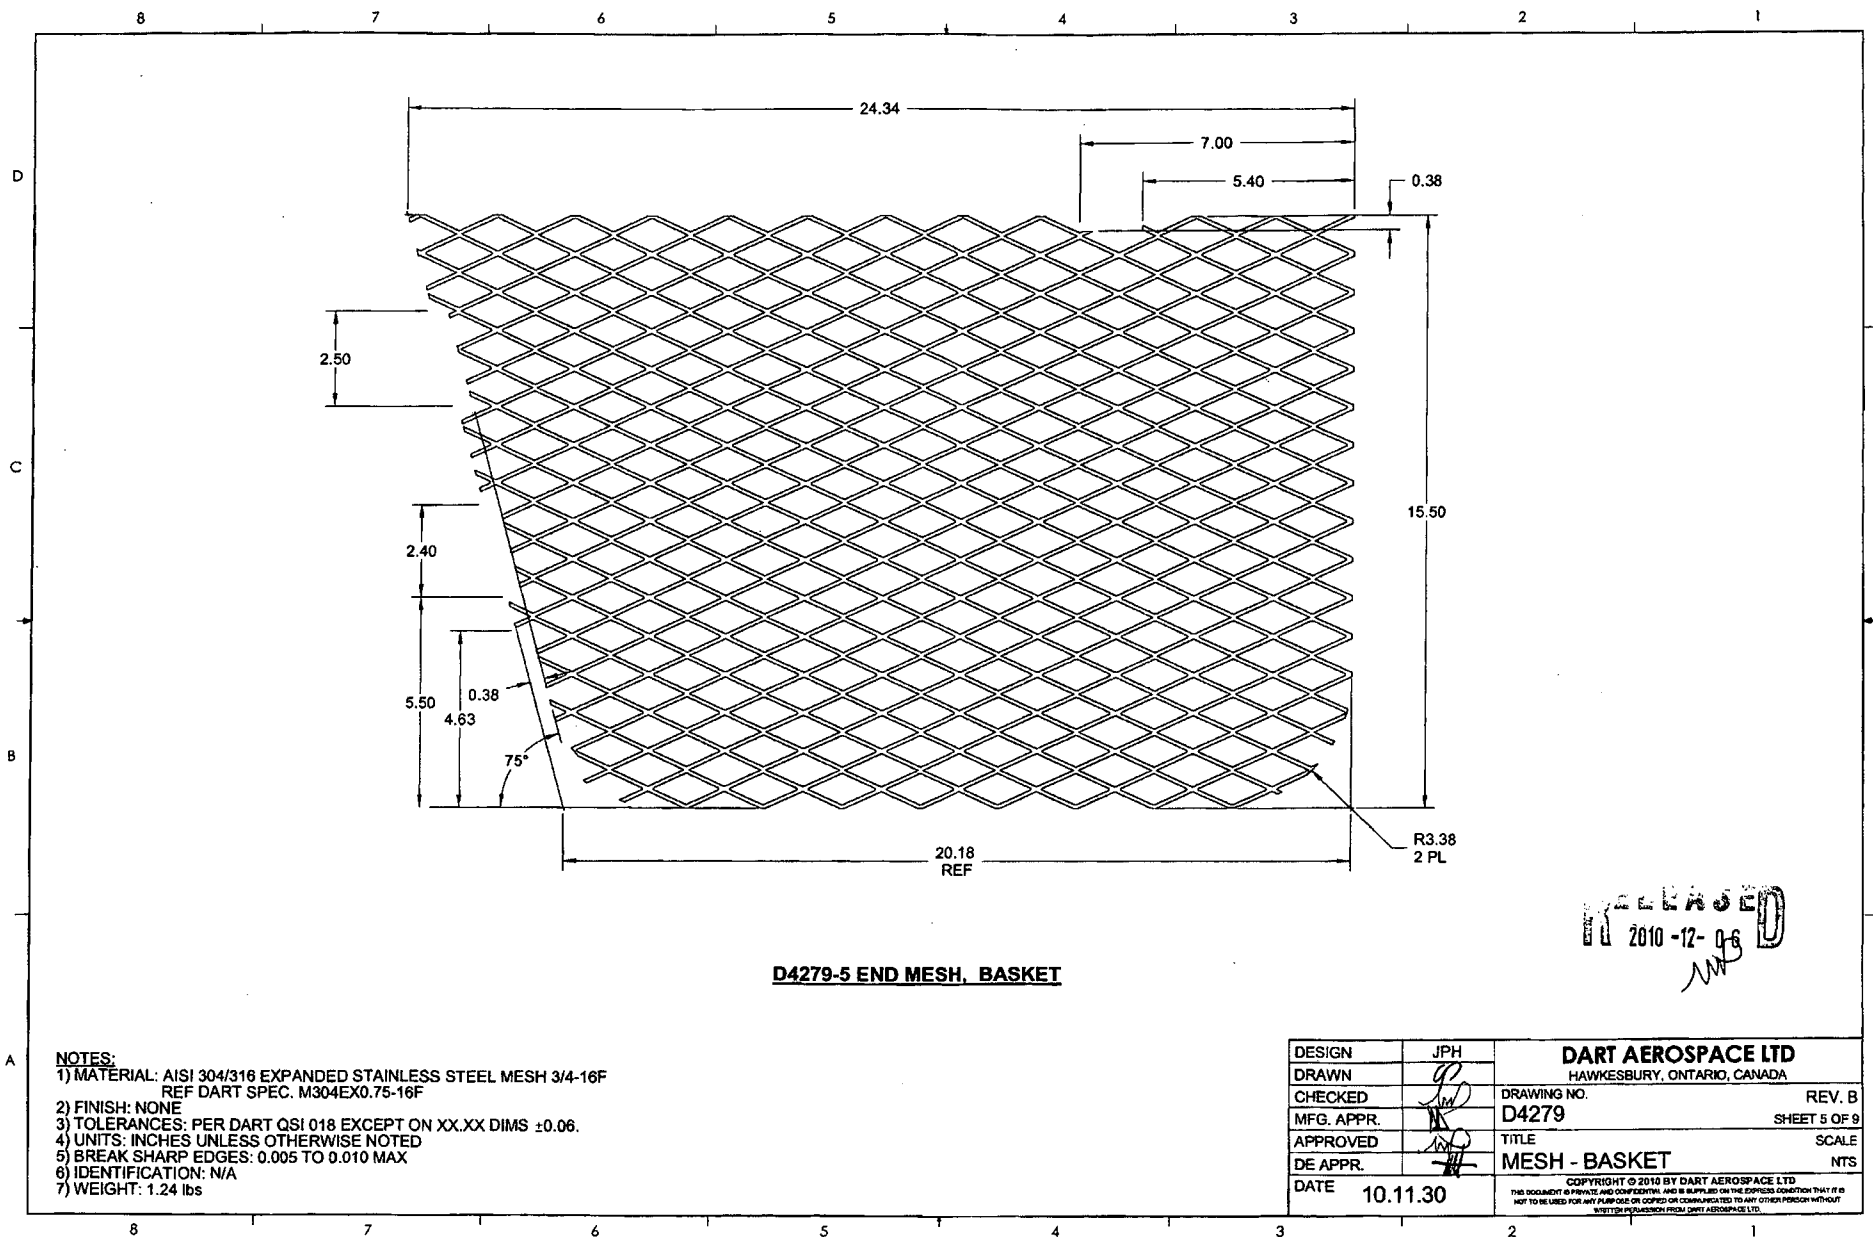

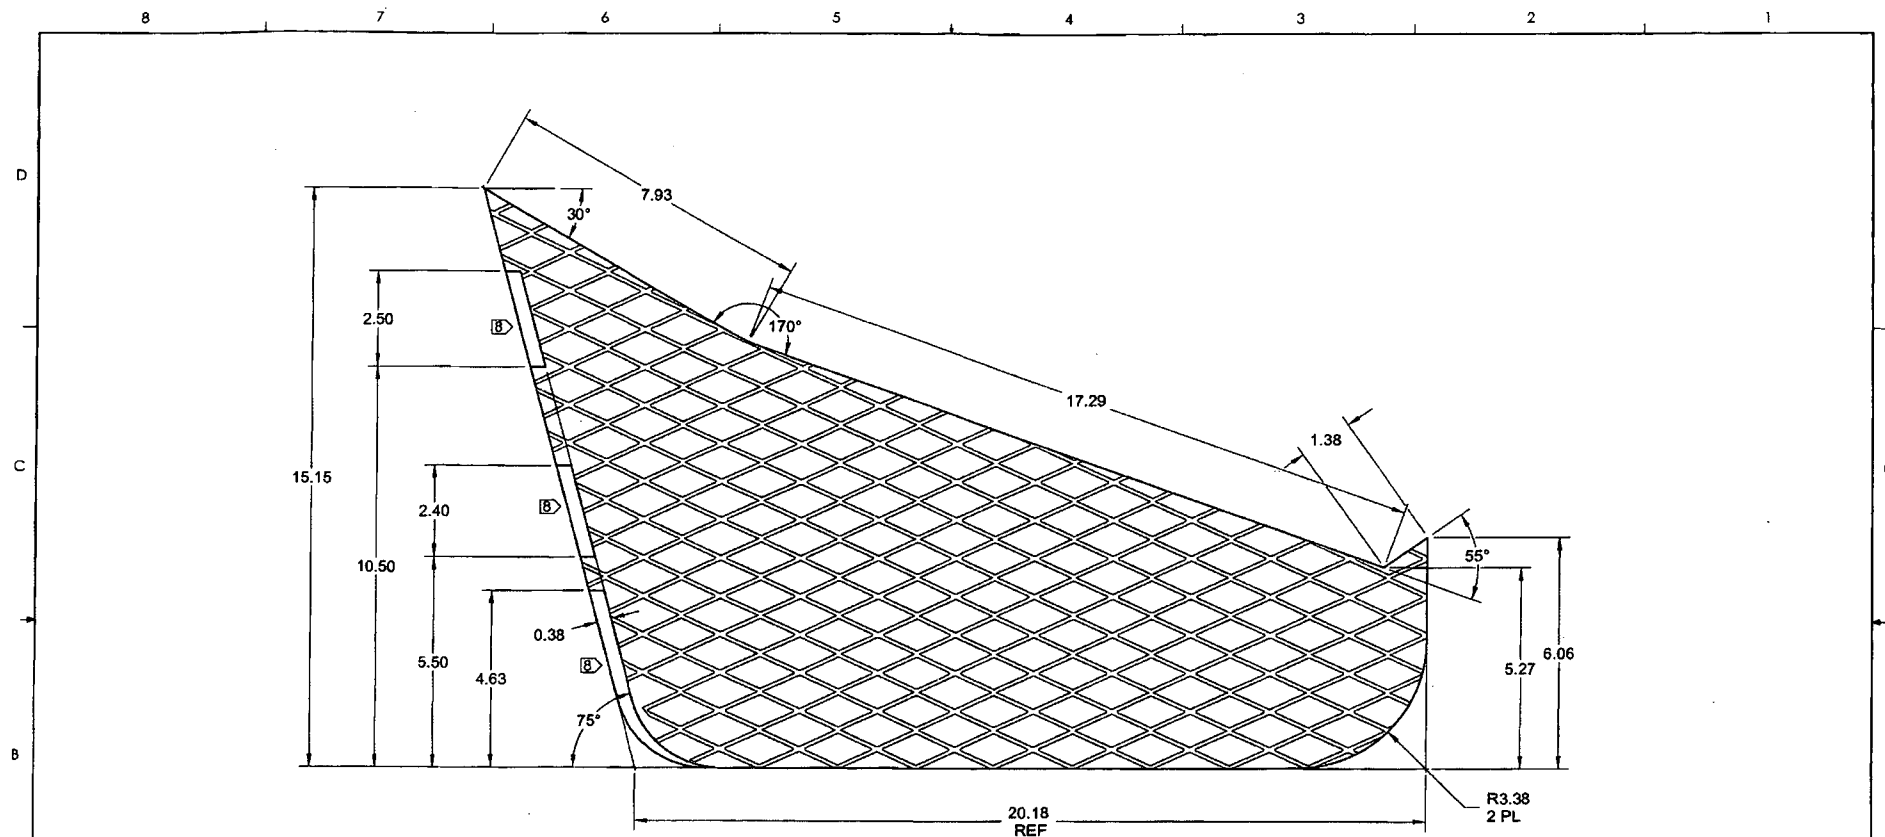


D4279-7 END MESH, BASKET

RELEASE
2010-12-06
ANN


NOTES:

- NOTES:**
- 1) MATERIAL: AISI 304/316 EXPANDED STAINLESS STEEL MESH 3/4-16F
REF DART SPEC. M304EX0.75-16F
 - 2) FINISH: NONE
 - 3) TOLERANCES: PER DART Q51 018 EXCEPT ON XX.XX DIMS ± 0.06 .
 - 4) UNITS: INCHES UNLESS OTHERWISE NOTED
 - 5) BREAK SHARP EDGES: 0.005 TO 0.010 MAX
 - 6) IDENTIFICATION: N/A
 - 7) WEIGHT: 0.71 lbs
 - 8) TRIM ON INSTALLATION TO CLEAR HOLES (IF PRESENT)

DESIGN	JPH	DART AEROSPACE LTD	
DRAWN	<i>[Signature]</i>	HAWKESBURY, ONTARIO, CANADA	
CHECKED	<i>[Signature]</i>	DRAWING NO.	REV. B
MFG. APPR.	<i>[Signature]</i>	D4279	SHEET 6 OF 8
APPROVED	<i>[Signature]</i>	TITLE	SCALE
DE APPR.	<i>[Signature]</i>	MESH - BASKET	NTS
DATE	10.11.30	COPYRIGHT © 2010 BY DART AEROSPACE LTD THIS DOCUMENT IS PART OF AND CONSIDERED TO BE SUPPLIED ON THE EXPRESS UNDERSTANDING THAT IT IS NOT TO BE USED FOR ANY PURPOSES OR COPIED OR REPRODUCED IN ANY OTHER MANNER WITHOUT	

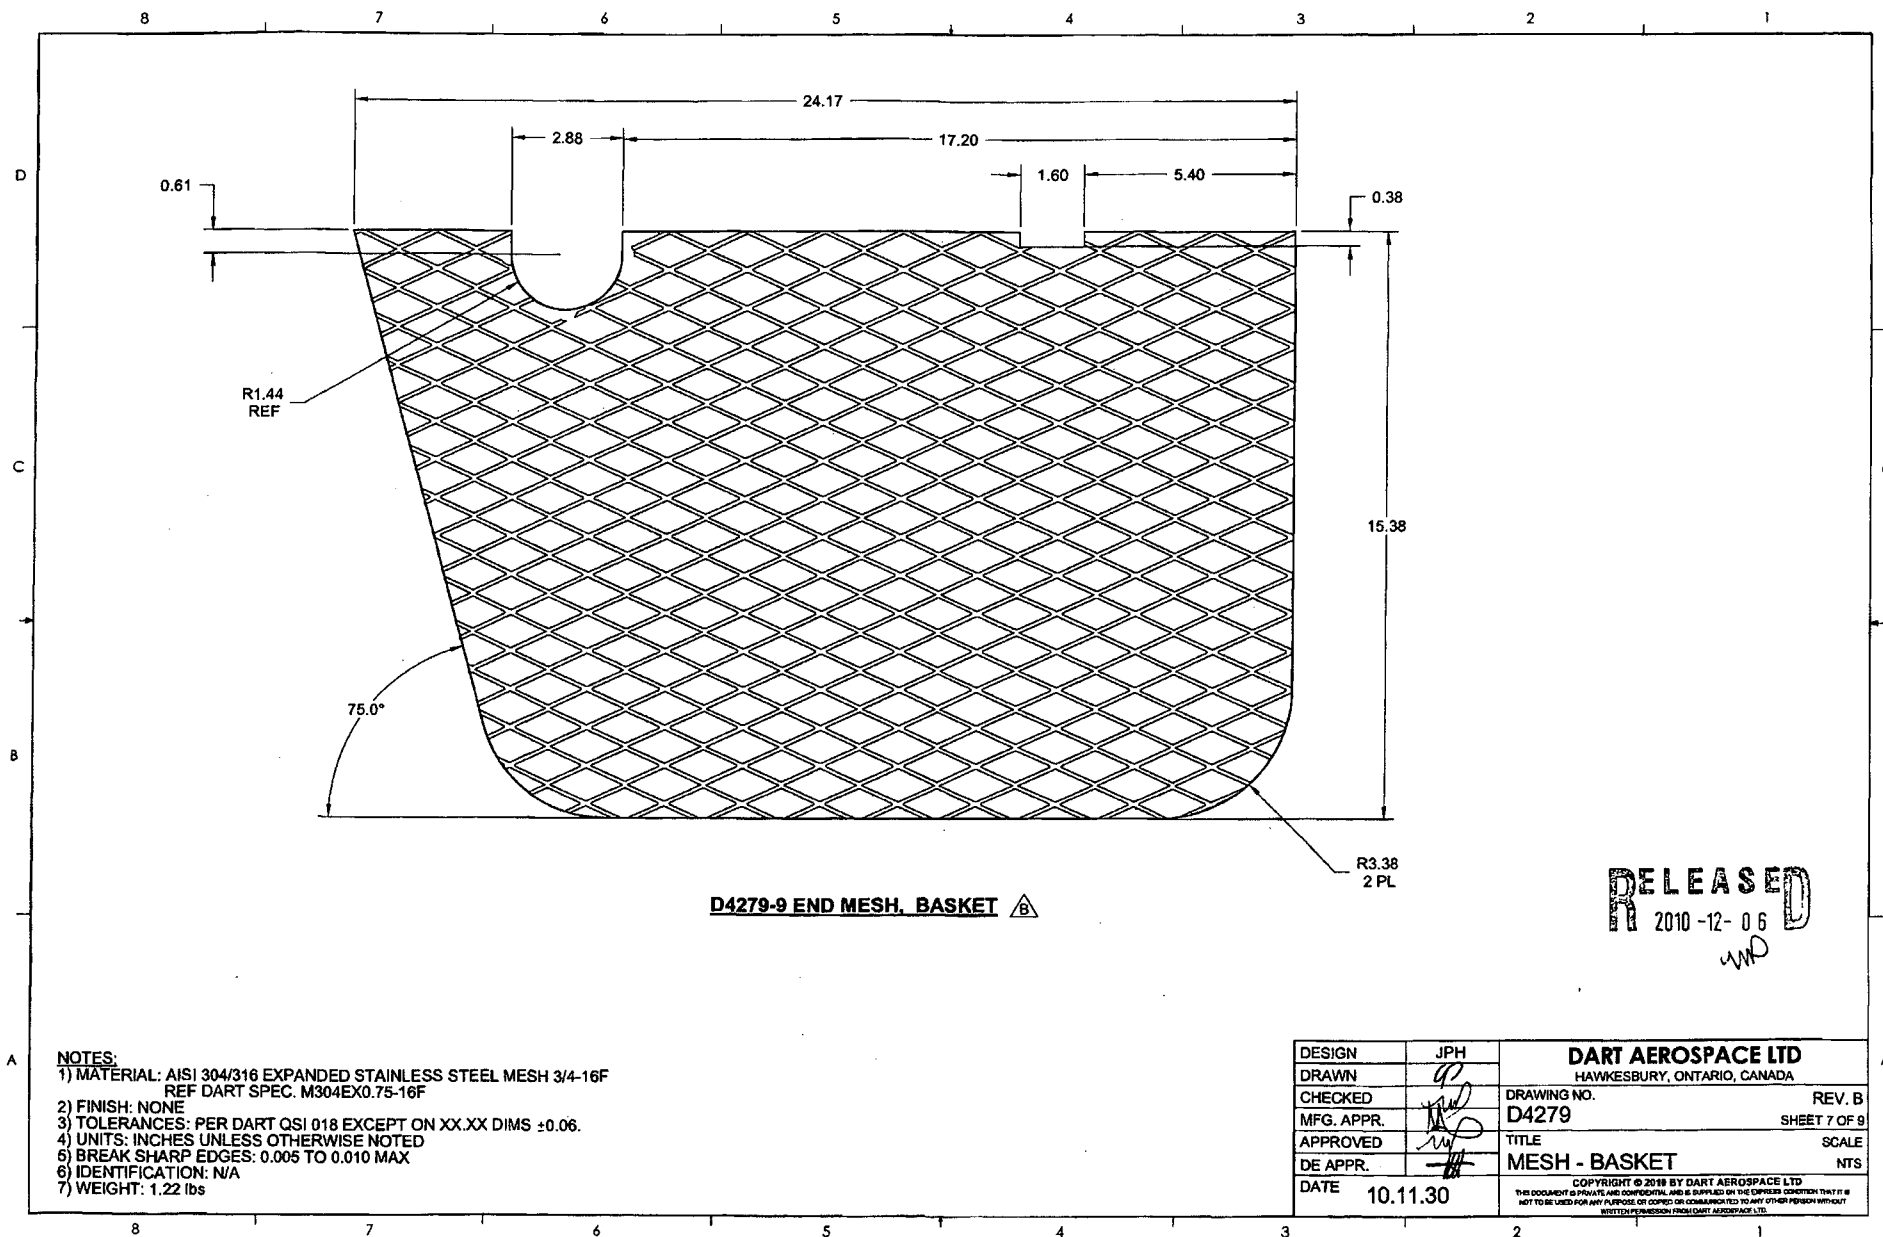


RELEASED
2010-12-06
WMD

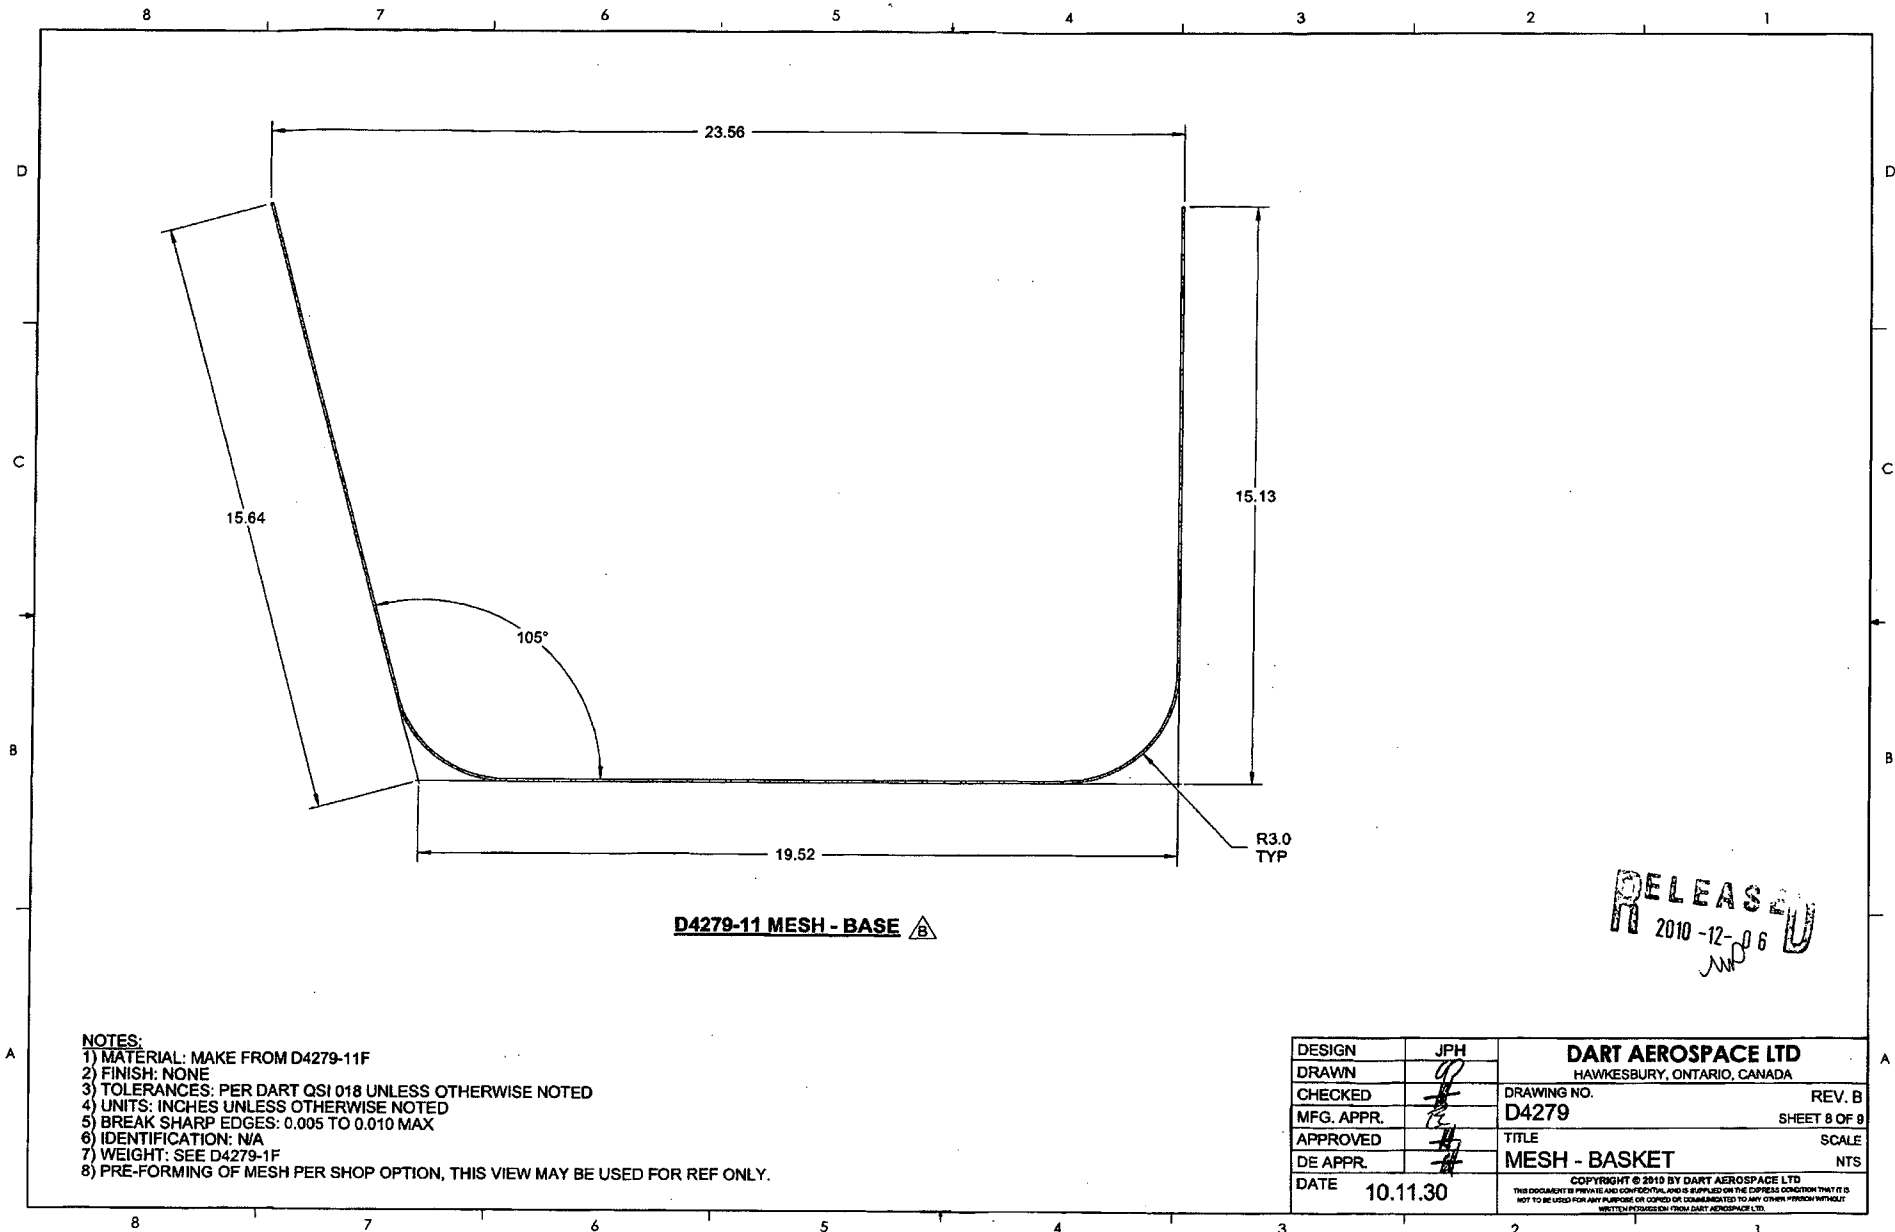

NOTES:

- 1) MATERIAL: MAKE FROM D4279-11F
- 2) FINISH: NONE
- 3) TOLERANCES: PER DART QSI 018 UNLESS OTHERWISE NOTED
- 4) UNITS: INCHES UNLESS OTHERWISE NOTED
- 5) BREAK SHARP EDGES: 0.005 TO 0.010 MAX
- 6) IDENTIFICATION: N/A
- 7) WEIGHT: SEE D4279-1F
- 8) PRE-FORMING OF MESH PER SHOP OPTION, THIS VIEW MAY BE USED FOR REF ONLY.

DESIGN	JPH	DART AEROSPACE LTD	
DRAWN	<i>[Signature]</i>	HAWKESBURY, ONTARIO, CANADA	
CHECKED	<i>[Signature]</i>	DRAWING NO.	REV. B
MFG. APPR.	<i>[Signature]</i>	D4279	SHEET 8 OF 9
APPROVED	<i>[Signature]</i>	TITLE	SCALE
DE APPR.	<i>[Signature]</i>	MESH - BASKET	NTS
DATE	10.11.30	COPYRIGHT © 2010 BY DART AEROSPACE LTD THIS DOCUMENT IS PRIVATE AND CONFIDENTIAL, AND IS SUPPLIED ON THE EXPRESS CONDITION THAT IT IS NOT TO BE USED FOR ANY PURPOSE OR COPIED OR REPRODUCED TO ANY OTHER PERSON WITHOUT WRITTEN PERMISSION FROM DART AEROSPACE LTD.	

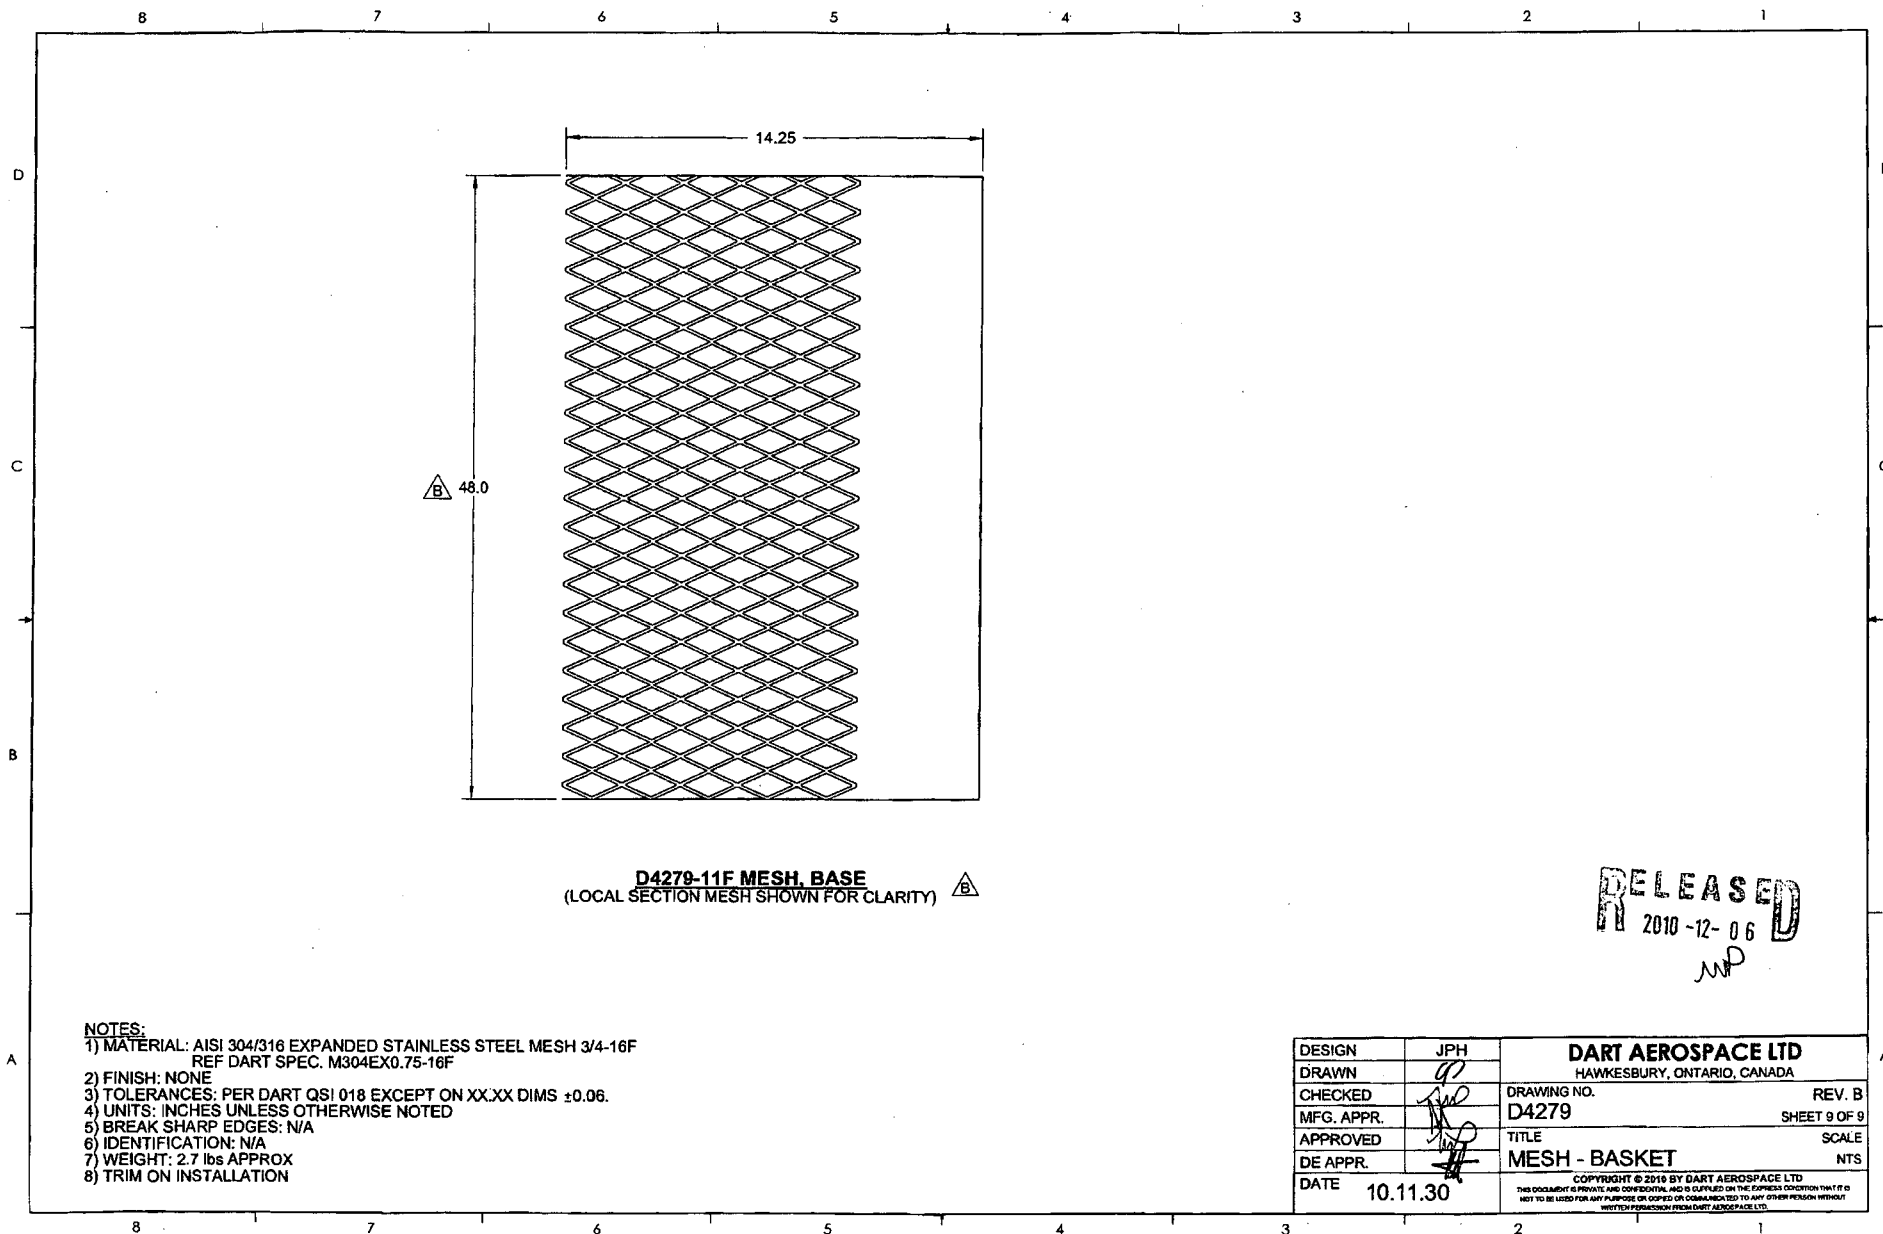

NOTES:

- 1) MATERIAL: AISI 304/316 EXPANDED STAINLESS STEEL MESH 3/4-16F
REF DART SPEC. M304EX0.75-16F
- 2) FINISH: NONE
- 3) TOLERANCES: PER DART QSI 018 EXCEPT ON XX.XX DIMS ± 0.06 .
- 4) UNITS: INCHES UNLESS OTHERWISE NOTED
- 5) BREAK SHARP EDGES: N/A
- 6) IDENTIFICATION: N/A
- 7) WEIGHT: 2.7 lbs APPROX
- 8) TRIM ON INSTALLATION

DESIGN	JPH	DART AEROSPACE LTD	
DRAWN	<i>[Signature]</i>	HAWKESBURY, ONTARIO, CANADA	
CHECKED	<i>[Signature]</i>	DRAWING NO.	REV. B
MFG. APPR.	<i>[Signature]</i>	D4279	SHEET 9 OF 9
APPROVED	<i>[Signature]</i>	TITLE	SCALE
DE APPR.	<i>[Signature]</i>	MESH - BASKET	NTS
DATE	10.11.30	COPYRIGHT © 2010 BY DART AEROSPACE LTD THIS DOCUMENT IS PRIVATE AND CONFIDENTIAL AND IS SUPPLIED ON THE EXPRESS CONDITION THAT IT IS NOT TO BE USED FOR ANY PURPOSE OR COPIED OR COMMUNICATED TO ANY OTHER PERSON WITHOUT WRITTEN PERMISSION FROM DART AEROSPACE LTD.	

RELEASED
2010-12-06
MP